


GENERAL NOTES

- THE INSTALLATION OF AN AUTOMATIC WET PIPE SPRINKLER SYSTEM SHALL PROVIDE FULL COVERAGE OF ALL AREAS OF THE BUILDING IN ACCORDANCE WITH THE UNIFORM FIRE CODE 1999 EDITION, NFPA 13 1999 EDITION- STANDARD FOR THE INSTALLATION OF SPRINKLER SYSTEMS.
- SUPPORT AND SEISMIC BRACING SHALL BE DESIGNED AND INSTALLED IN ACCORDANCE WITH NFPA 13 1999 EDITION, SECTION 6-4.5.
- ALL EXISTING DRY STANDPIPE HOSE GATE VALVES ON ALL RISERS AND ROOF MANIFOLDS SHALL BE REMOVED AND REPLACED WITH NEW WET TYPE ANGLE HOSE VALVES AS SPECIFIED.
- PROCEDURE TO CONVERT THE DRY STANDPIPE SYSTEMS SHALL BE AS FOLLOWS:
 - REPLACE EXISTING HOSE GATE VALVES PER ITEM 3 ABOVE.
 - VERIFY GASKETED PLUGS ARE INSTALLED AT FDC(S)
 - PERFORM AIR PRESSURE TEST ON EXISTING DRY STANDPIPE SYSTEMS AT 25 PSI MINIMUM TO DETERMINE IF THE SYSTEM LEAKS.
 - INSTALL NEW UNDERGROUND SUPPLIES, INCLUDING NEW FIRE DEPARTMENT CONNECTIONS, AND BULK MAIN PIPING THROUGHOUT BUILDING.
 - MAKE NEW VALVED CONNECTIONS TO EXISTING DRY STANDPIPES AND DISCONNECT FROM EXISTING FIRE DEPARTMENT CONNECTIONS. CONVERSION OF EACH STANDPIPE SHALL NOW RENDER THE STANDPIPE INOPERATIVE (I.E. WITHOUT AN FDC) FOR AN EXTENDED PERIOD.
 - PERFORM HYDROSTATIC PRESSURE TEST AT 200 PSI FOR 2 HOURS OF ENTIRE WET STANDPIPE SYSTEM.
 - PERFORM FLUSHING OF NEWLY CONVERTED WET STANDPIPES BY FLUSHING AT TOPMOST VALVES.
- ALL SHUT DOWNS OF CAMPUS UTILITIES SHALL BE DONE BY UNIVERSITY FACILITIES PERSONNEL.
- SUPPORT AND SEISMIC BRACING OF EXISTING STANDPIPE AND SPRINKLER PIPING SHALL BE UPGRADED TO APPLICABLE PRESENT CODE REQUIREMENTS AS NECESSARY.
- ALL ACCESS OPENINGS IN WALLS, PARTITIONS AND CEILINGS CREATED BY THE REMOVAL OF EXISTING PIPING OR INSTALLATION OF NEW PIPING SHALL BE PATCHED AND PAINTED BY THE CONTRACTOR. PATCH SHALL MATCH THE ADJACENT AREA AS TO METHOD, FIRE RATING, MATERIAL, COLOR AND TEXTURE.
- ALL NEW PIPING SHALL BE INSTALLED CONCEALED WITHIN EXISTING OR NEW WALLS, CEILINGS, FURRED SPACES, OR SOFFITS UNLESS APPROVED BY UNIVERSITY'S REPRESENTATIVE. ALL EXPOSED EXTERIOR AND INTERIOR PIPING, FITTINGS, VALVES AND DEVICES SHALL BE PAINTED AS DESCRIBED IN THE SPECIFICATIONS.
- ALL EXISTING FIRE ALARM SYSTEMS SHALL BE MAINTAINED OPERATIONAL AT ALL TIMES DURING THE ALTERATION. CONNECTION IN EXISTING SYSTEMS SHALL BE COORDINATED WITH THE UNIVERSITY.
- APPROVED FIRE STOPPING MATERIALS, ASSEMBLIES AND INSTALLATION SHALL BE USED AT ALL PENETRATIONS THROUGH FIRE RATED FLOORS, WALLS, PARTITIONS AND BARRIERS.
- ALL PIPES CROSSING BUILDING SEISMIC JOINTS SHALL BE WITH APPROVED TYPE DESIGN, JOINTS AND ANCHORS. CONTRACTOR SHALL VERIFY LOCATION AND TYPE OF EXISTING BUILDING JOINTS.
- ALL VALVES, CONTROLS, GAUGES AND DEVICES SHALL BE READILY ACCESSIBLE, EXPOSED OR CONCEALED BEHIND ACCESS PANELS OR DOORS AS APPROVED BY THE UNIVERSITY REPRESENTATIVE.
- ALL TEMPORARY ACCESS OPENINGS MADE BY THE CONTRACTOR FOR OBSERVATION OR INSTALLATION SHALL BE PROMPTLY COVERED EACH DAY WITH UNIVERSITY APPROVED MATERIALS.
- ALL SYSTEM CONTROL OR SHUT-OFF VALVES SHALL BE EQUIPPED WITH A TAMPER SWITCH WHICH SHALL BE CONNECTED INTO THE BUILDING'S EXISTING FIRE ALARM SYSTEM. REFER TO SPECIFICATIONS FOR REQUIRED WORK AND PROGRAMMING SYSTEM.

DRAWING INDEX

- SHEET 1 LEGEND, MAP & GENERAL NOTES
- SHEET 2 1000 LEVEL WET STANDPIPE & UNDERGROUND
- SHEET 3 2000 LEVEL WET STANDPIPE- BOELTER HALL
- SHEET 4 3000 LEVEL WET STANDPIPE- MATH SCIENCES
- SHEET 5 4000 LEVEL WSP- MATH SCIENCES & BOELTER HALL
- SHEET 6 5000 LEVEL WSP - MATH SCIENCES
- SHEET 7 9000 LEVEL WET STANDPIPE & REMOTE SPRINKLERS
- SHEET 8 ISOMETRIC RISER DIAGRAM
- SHEET 9 HANGERS & BRACING DETAILS & CALCULATIONS
- SHEET 10 BOELTER HALL 1000 LEVEL FIRE SPRINKLER PLAN
- SHEET 11 BOELTER HALL 2000 LEVEL FIRE SPRINKLER PLAN
- SHEET 12 BOELTER HALL 3000 LEVEL FIRE SPRINKLER PLAN
- SHEET 13 BOELTER HALL 4000 LEVEL FIRE SPRINKLER PLAN
- SHEET 14 BOELTER HALL 5000 LEVEL FIRE SPRINKLER PLAN
- SHEET 15 BOELTER HALL 6000 LEVEL FIRE SPRINKLER PLAN
- SHEET 16 BOELTER HALL 7000 LEVEL FIRE SPRINKLER PLAN
- SHEET 17 BOELTER HALL 8000 LEVEL FIRE SPRINKLER PLAN
- SHEET 18 BOELTER HALL 9000 LEVEL FIRE SPRINKLER PLAN
- SHEET 19 MATH SCIENCE 1000 LEVEL FIRE SPRINKLER PLAN
- SHEET 20 MATH SCIENCE 2000 LEVEL FIRE SPRINKLER PLAN
- SHEET 21 MATH SCIENCE 4000 LEVEL FIRE SPRINKLER PLAN
- SHEET 22 MATH SCIENCE 5000 LEVEL FIRE SPRINKLER PLAN
- SHEET 23 MATH SCIENCE 6000 LEVEL FIRE SPRINKLER PLAN
- SHEET 24 MATH SCIENCE 7000 LEVEL FIRE SPRINKLER PLAN
- SHEET 25 MATH SCIENCE 8000 LEVEL FIRE SPRINKLER PLAN
- SHEET 26 MATH SCIENCE 9000 LEVEL FIRE SPRINKLER PLAN

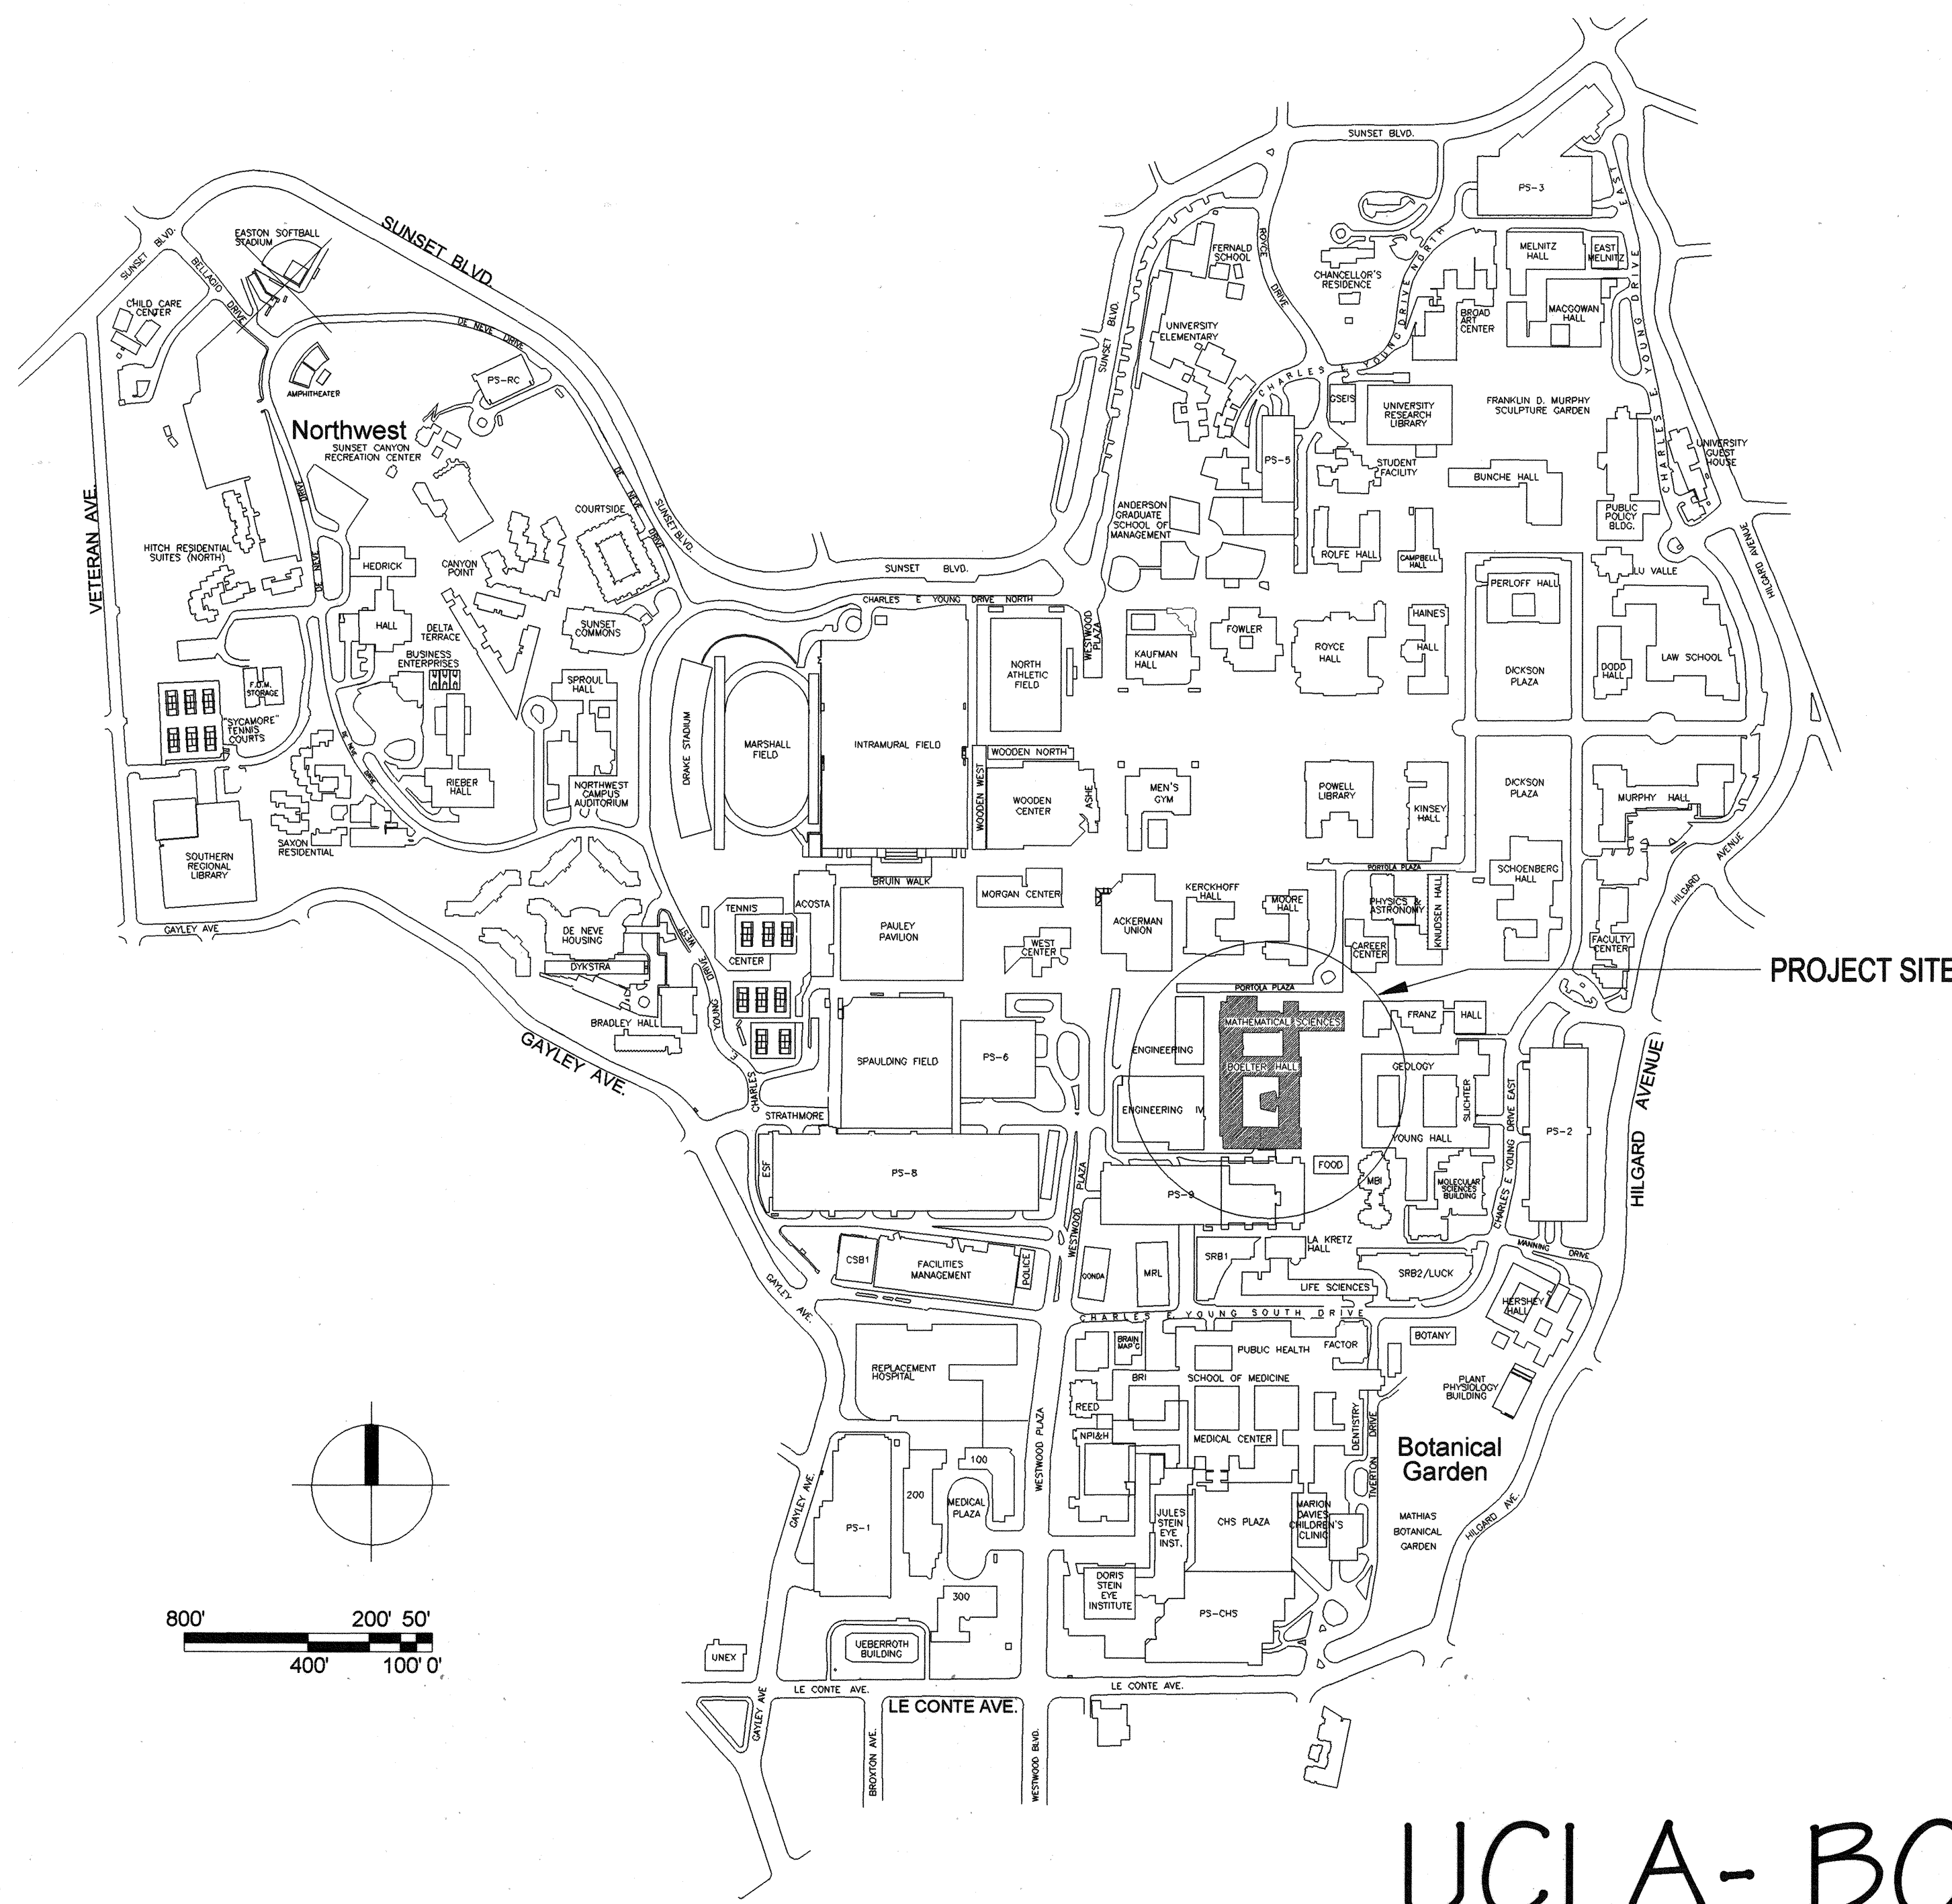

CAMPUS MAP

UCLA- BOELTER HALL FIRE SPRINKLER SYSTEM FIRE SPRINKLER & WET STANDPIPE SHOP DRAWINGS

LEGEND

SYMBOL	DESCRIPTION
---	(E) EXISTING PIPING
---	NEW PIPING
DBP	DRY STANDPIPE
FS	FIRE SPRINKLER PIPING
D	DRAIN
OS+Y	OUTSIDE SCREW/YOKE VALVE
BFV	BUTTERFLY VALVE
RCV	RISER CONTROL VALVE
SOV	SHUT-OFF VALVE
HGV	HOSE GATE VALVE
OR POC	POINT OF CONNECTION
OR	EXISTING FIRE SPRINKLER RISER
BH	SYMBOL FOR EXISTING RISER
STAIR & RISER NUMBER	METRAFLEX "FIRELOOP" SEISMIC ASSEMBLY
+	BUTTERFLY VALVE W/ TAMPER SWITCH
+	4-WAY SWAY BRACE
+	2-WAY SWAY BRACE
+	PIPE HANGER
+	GROOVED PIPE COUPLING
###	HYDRAULIC CALCULATION REFERENCE NODE
#	REFERENCE TO NOTE
●	RECESSED PENDENT SPRINKLER HEAD
○	UPRIGHT SPRINKLER HEAD
[10'-0"]	PIPE ELEVATION
[8'-0"]	CEILING ELEVATION


FLOW TEST INFORMATION

TWO FLOW TESTS FOR THIS PROJECT WERE CONDUCTED ON SEPTEMBER 8, 2004 BETWEEN 6 AND 7 AM. THE FIRST FLOW TEST UTILIZED THE FIRE HYDRANT ON THE NORTH SIDE OF PARKING STRUCTURE 9 AND THE SOUTH WEST CORNER OF BOELTER HALL AS THE FLOW HYDRANT (IDENTIFIED AS #1 ON THE MAP ON THIS SHEET). THE STATIC AND RESIDUAL PRESSURES WERE RECORDED FROM A GAUGE PLACED ON THE HYDRANT (#2) LOCATED ON WESTWOOD PLAZA AT THE NORTH WEST CORNER OF PARKING STRUCTURE #9. THE RESULTS OF THAT FLOW TEST ARE AS FOLLOWS:

- STATIC PRESSURE: 158 PSI
- RESIDUAL PRESSURE: 140 PSI
- HYDRANT OUTLET DIAMETER: 2 1/2" (SMOOTH BORE NOZZLE)
- PISTON PRESSURE: 73 PSI
- FLOW: 1594 GPM

THE SECOND FLOW TEST UTILIZED THE FIRE HYDRANT (#3) IN THE "TURNAROUND" ON PORTOLA PLAZA. THE STATIC AND RESIDUAL PRESSURES WERE RECORDED FROM A GAUGE PLACED ON THE HYDRANT (#4) LOCATED ACROSS FROM MATH SCIENCE BUILDING. THE RESULTS OF THAT FLOW TEST ARE AS FOLLOWS:

- STATIC PRESSURE: 145 PSI
- RESIDUAL PRESSURE: 120 PSI
- HYDRANT OUTLET DIAMETER: 2 1/2" (SMOOTH BORE NOZZLE)
- PISTON PRESSURE: 70 PSI
- FLOW: 1561 GPM

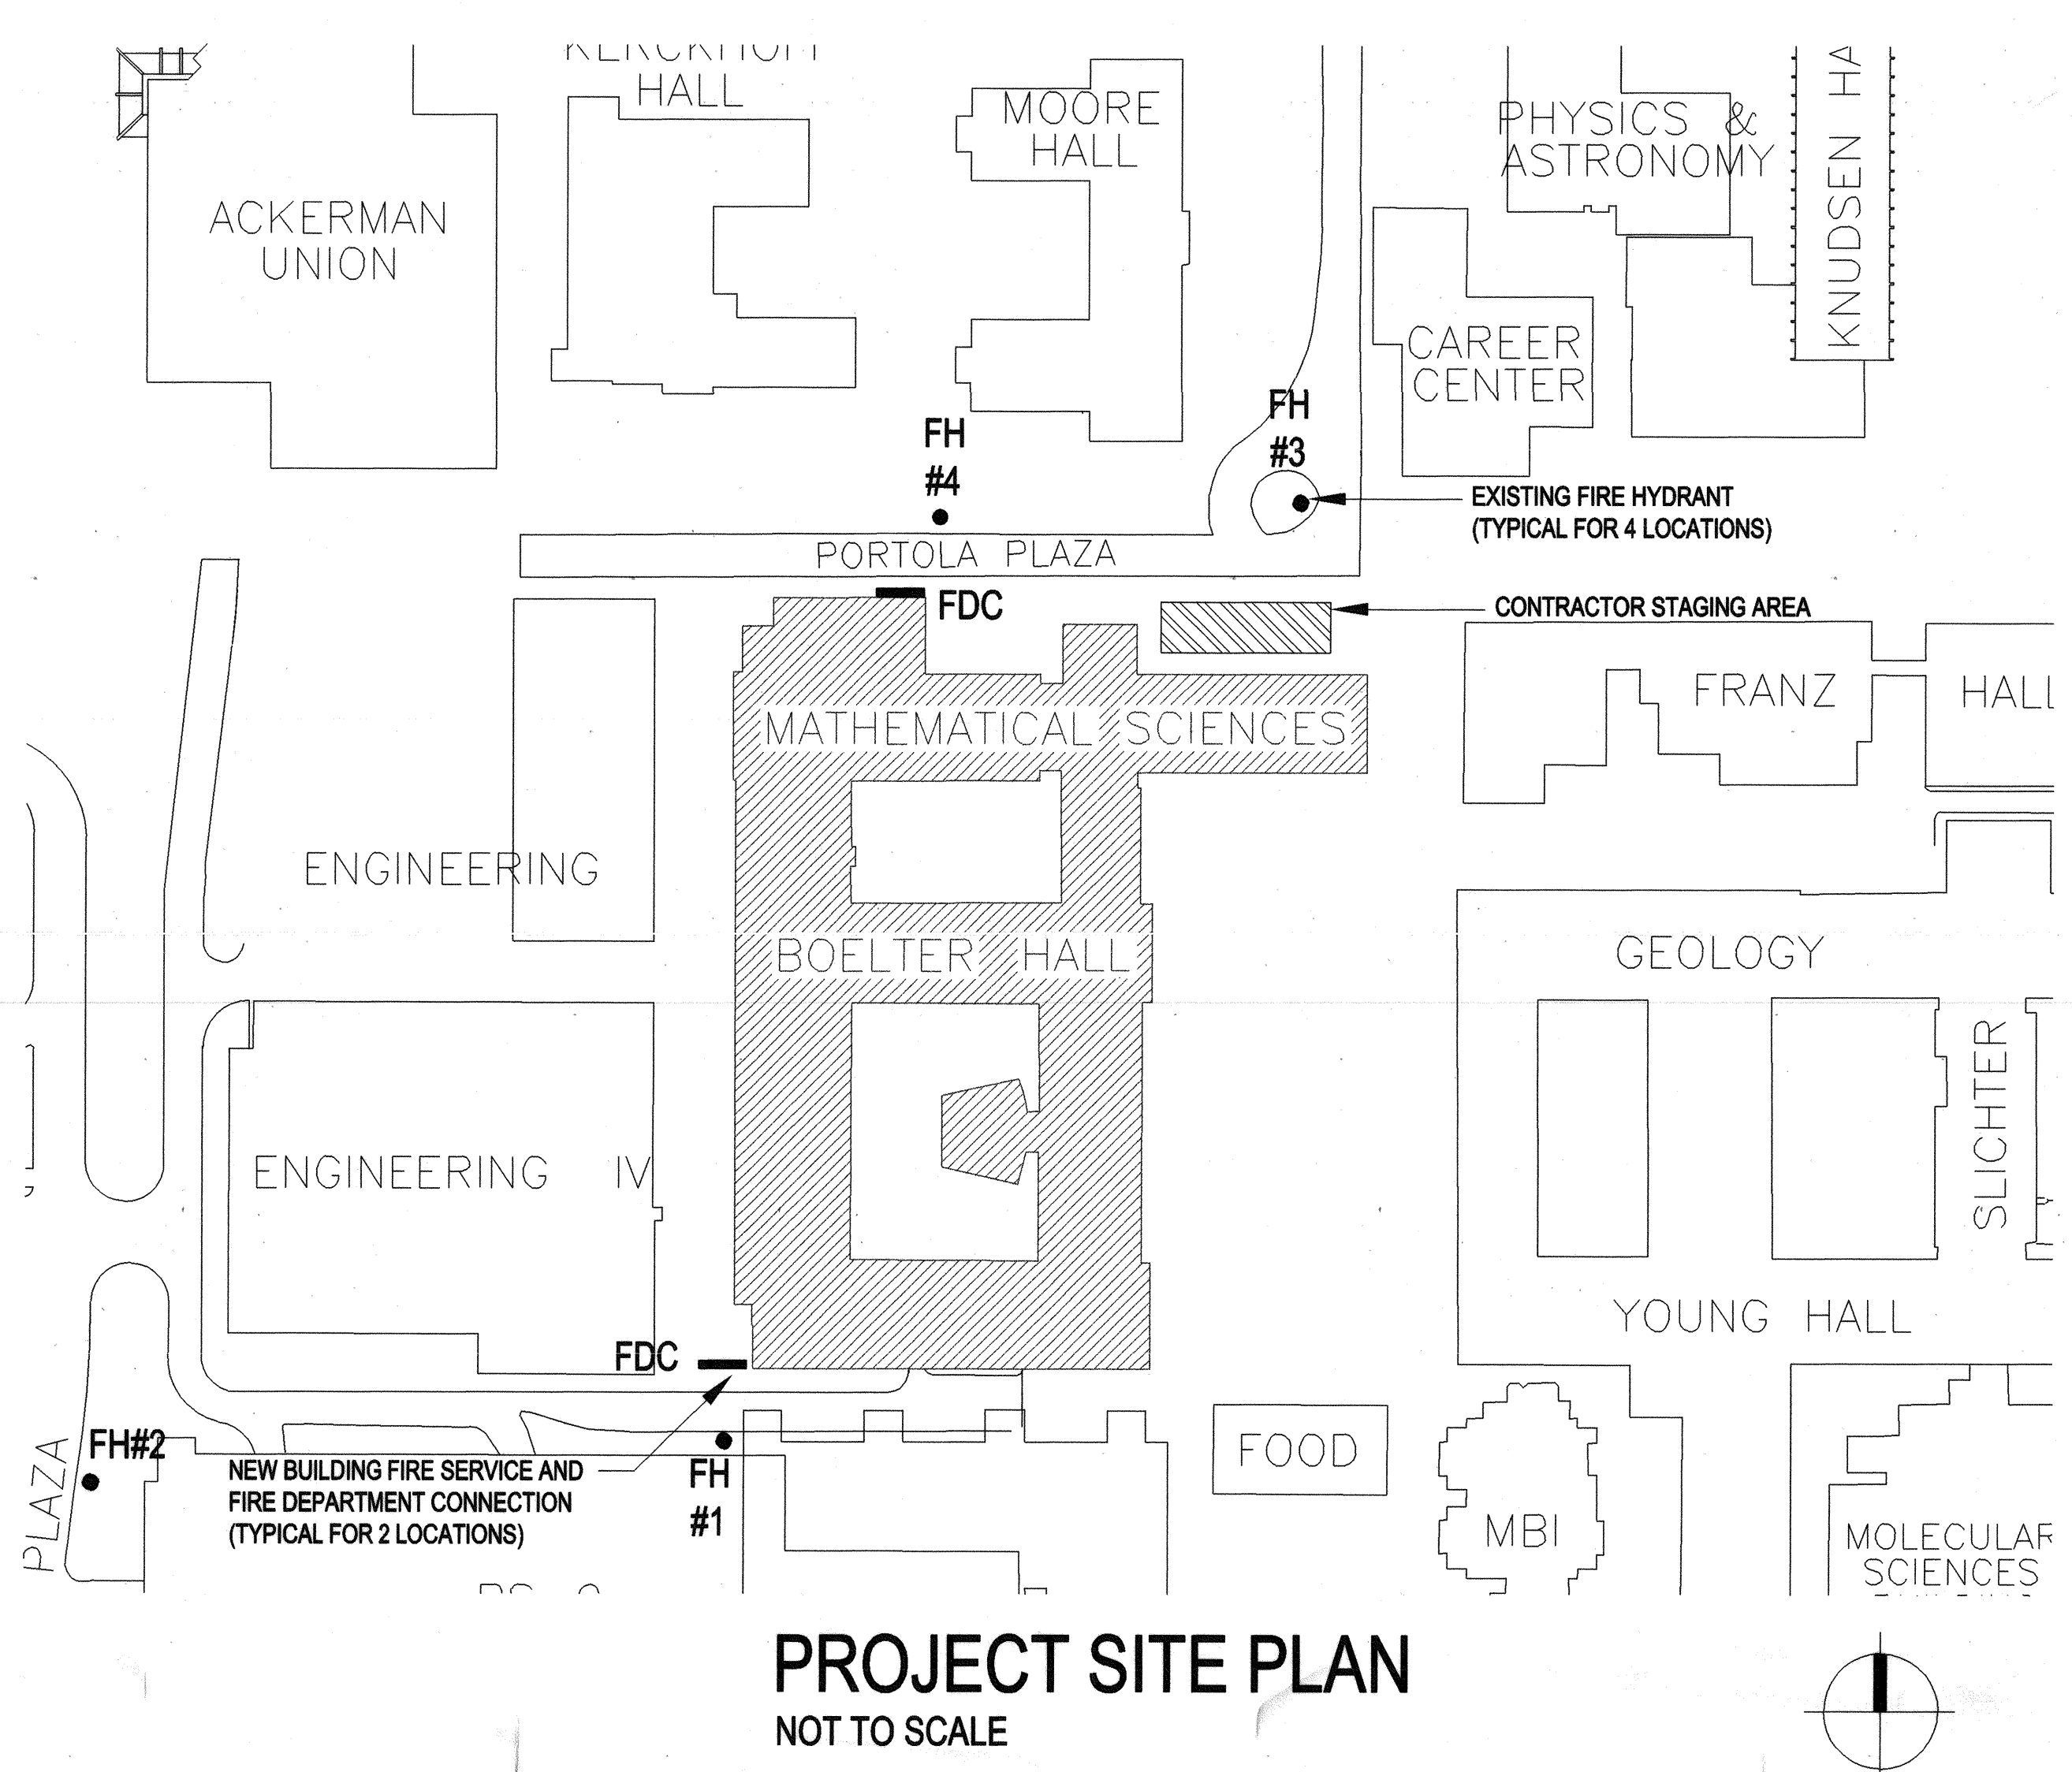

PROJECT SITE PLAN
NOT TO SCALE

BUILDING INFORMATION

BOELTER HALL (ENGINEERING II & III)

Building Address: 550 Portola Plaza
 1969
 Engineering II Construction Date: 1961
 Engineering III Construction Date: 1968
 Combined Gross Area: 564,100 sf.
 Combined Covered Unenclosed: 33,700 sf.
 Combined Assignable: 234,280 sf.
 Number of Floors: 9
 Construction Type: Type I (F.R.)
 Occupancy: B
 Existing Fire Protection Systems: Class I - Dry standpipe system with 2 1/2" hose valves in each stairwell. Each riser has its own fire department connection; risers are not interconnected.
 Class II - Wet standpipe system with 1 1/2" hose valves are located throughout the building.

MATHEMATICAL SCIENCES

Building Address: 520 Portola Plaza
 1957 (Number of Floors 5)
 Original Building Construction Date: 1968 (Number of Floors 9)
 Additional Construction Date: 1968
 Combined Gross Area: 224,100 sf.
 Combined Covered Unenclosed: 3,300 sf.
 Combined Assignable: 127,040 sf.
 Number of Floors: 9
 Construction Type: Type I (F.R.)
 Occupancy: B
 Existing Fire Protection Systems: Class I - Dry standpipe system with 2 1/2" hose valves in each stairwell. Each riser has its own fire department connection; risers are not interconnected.
 Class II - Wet standpipe system with 1 1/2" hose valves are located throughout the building.

Automatic wet pipe sprinkler systems on floors 1, 2 and 3 only.

MATH SCIENCES - BUILDING NO. 30A
520 PORTOLA PLAZA
SECONDARY WATER SUPPLY LOCATED AT SOUTH-WEST CORNER OF BOELTER HALL
580 PORTOLA PLAZA
COMBINED FIRE SPRINKLER STANDPIPE FIRE DEPARTMENT CONNECTION PRESSURE REQUIRED: 145 PSI


BOELTER HALL - BUILDING NO. 30B
580 PORTOLA PLAZA
SECONDARY WATER SUPPLY LOCATED AT NORTH SIDE OF MATH SCIENCES
520 PORTOLA PLAZA
COMBINED FIRE SPRINKLER STANDPIPE FIRE DEPARTMENT CONNECTION PRESSURE REQUIRED: 155 PSI

CAMPUS FACILITIES EMERGENCY TROUBLE CALL:
310-825-9236 (24 HOUR HOTLINE)
OR DIAL 99236 FROM A CAMPUS PHONE

POLICE OR MEDICAL EMERGENCY CALL 911


AS BUILT
UCLA PROJECT NO. 946231.01

AUTOMATIC FIRE PROTECTION PLAN			
UCLA - BOELTER HALL FIRE SPRINKLER SYSTEM PROJECT INFO, NOTES & LEGEND			
OWNER	UCLA	DATE	10/2/04
CONTRACTOR	DIRECT	SCALE	AS SHOWN
JOB NO.	04-11	DRAWN BY	DBB
		CHECKED BY	
		APPROVED BY	
		DATE	
		SHEET NO.	1 OF 28

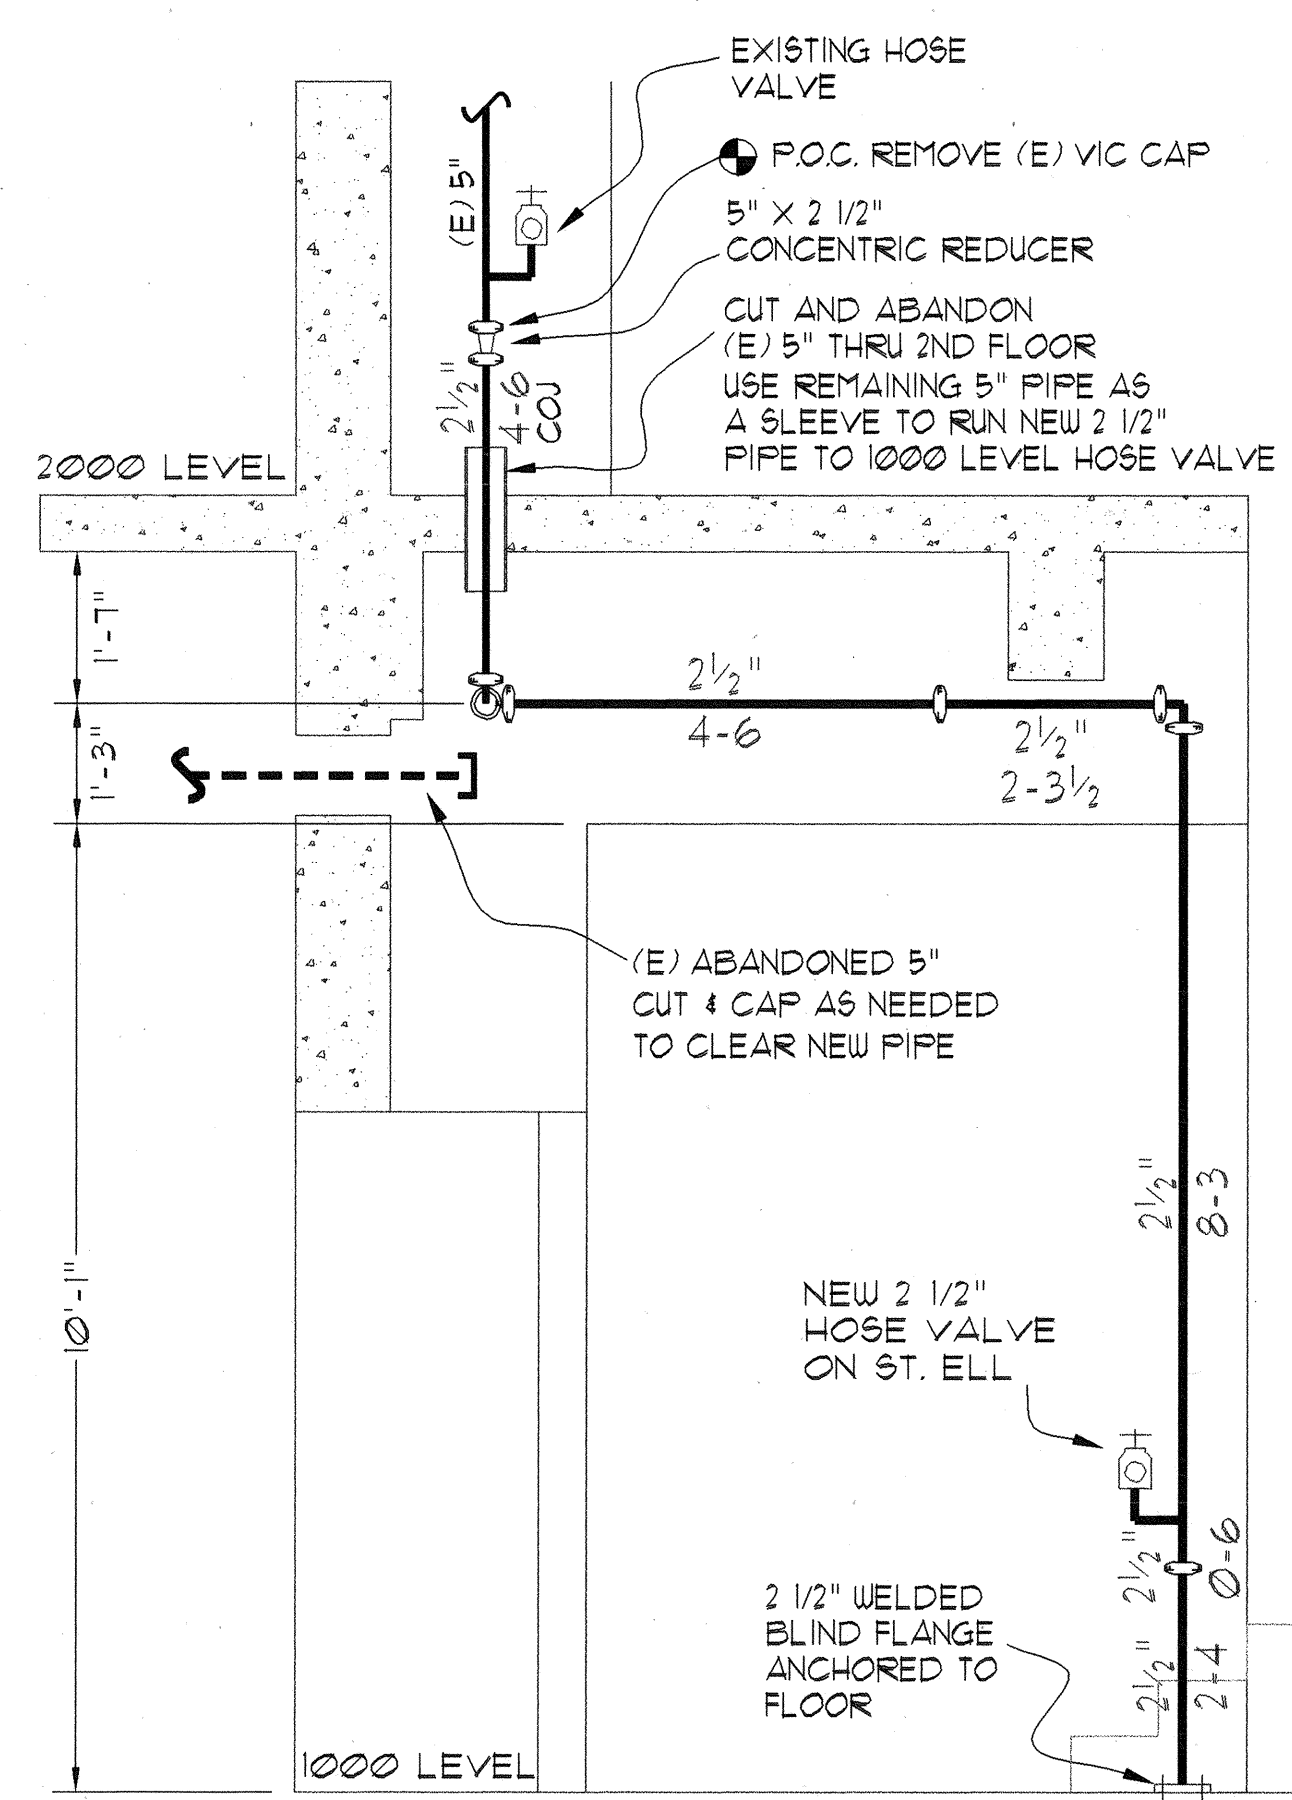


SECTION 3


TYPICAL DETAIL OF EXIST. FDC

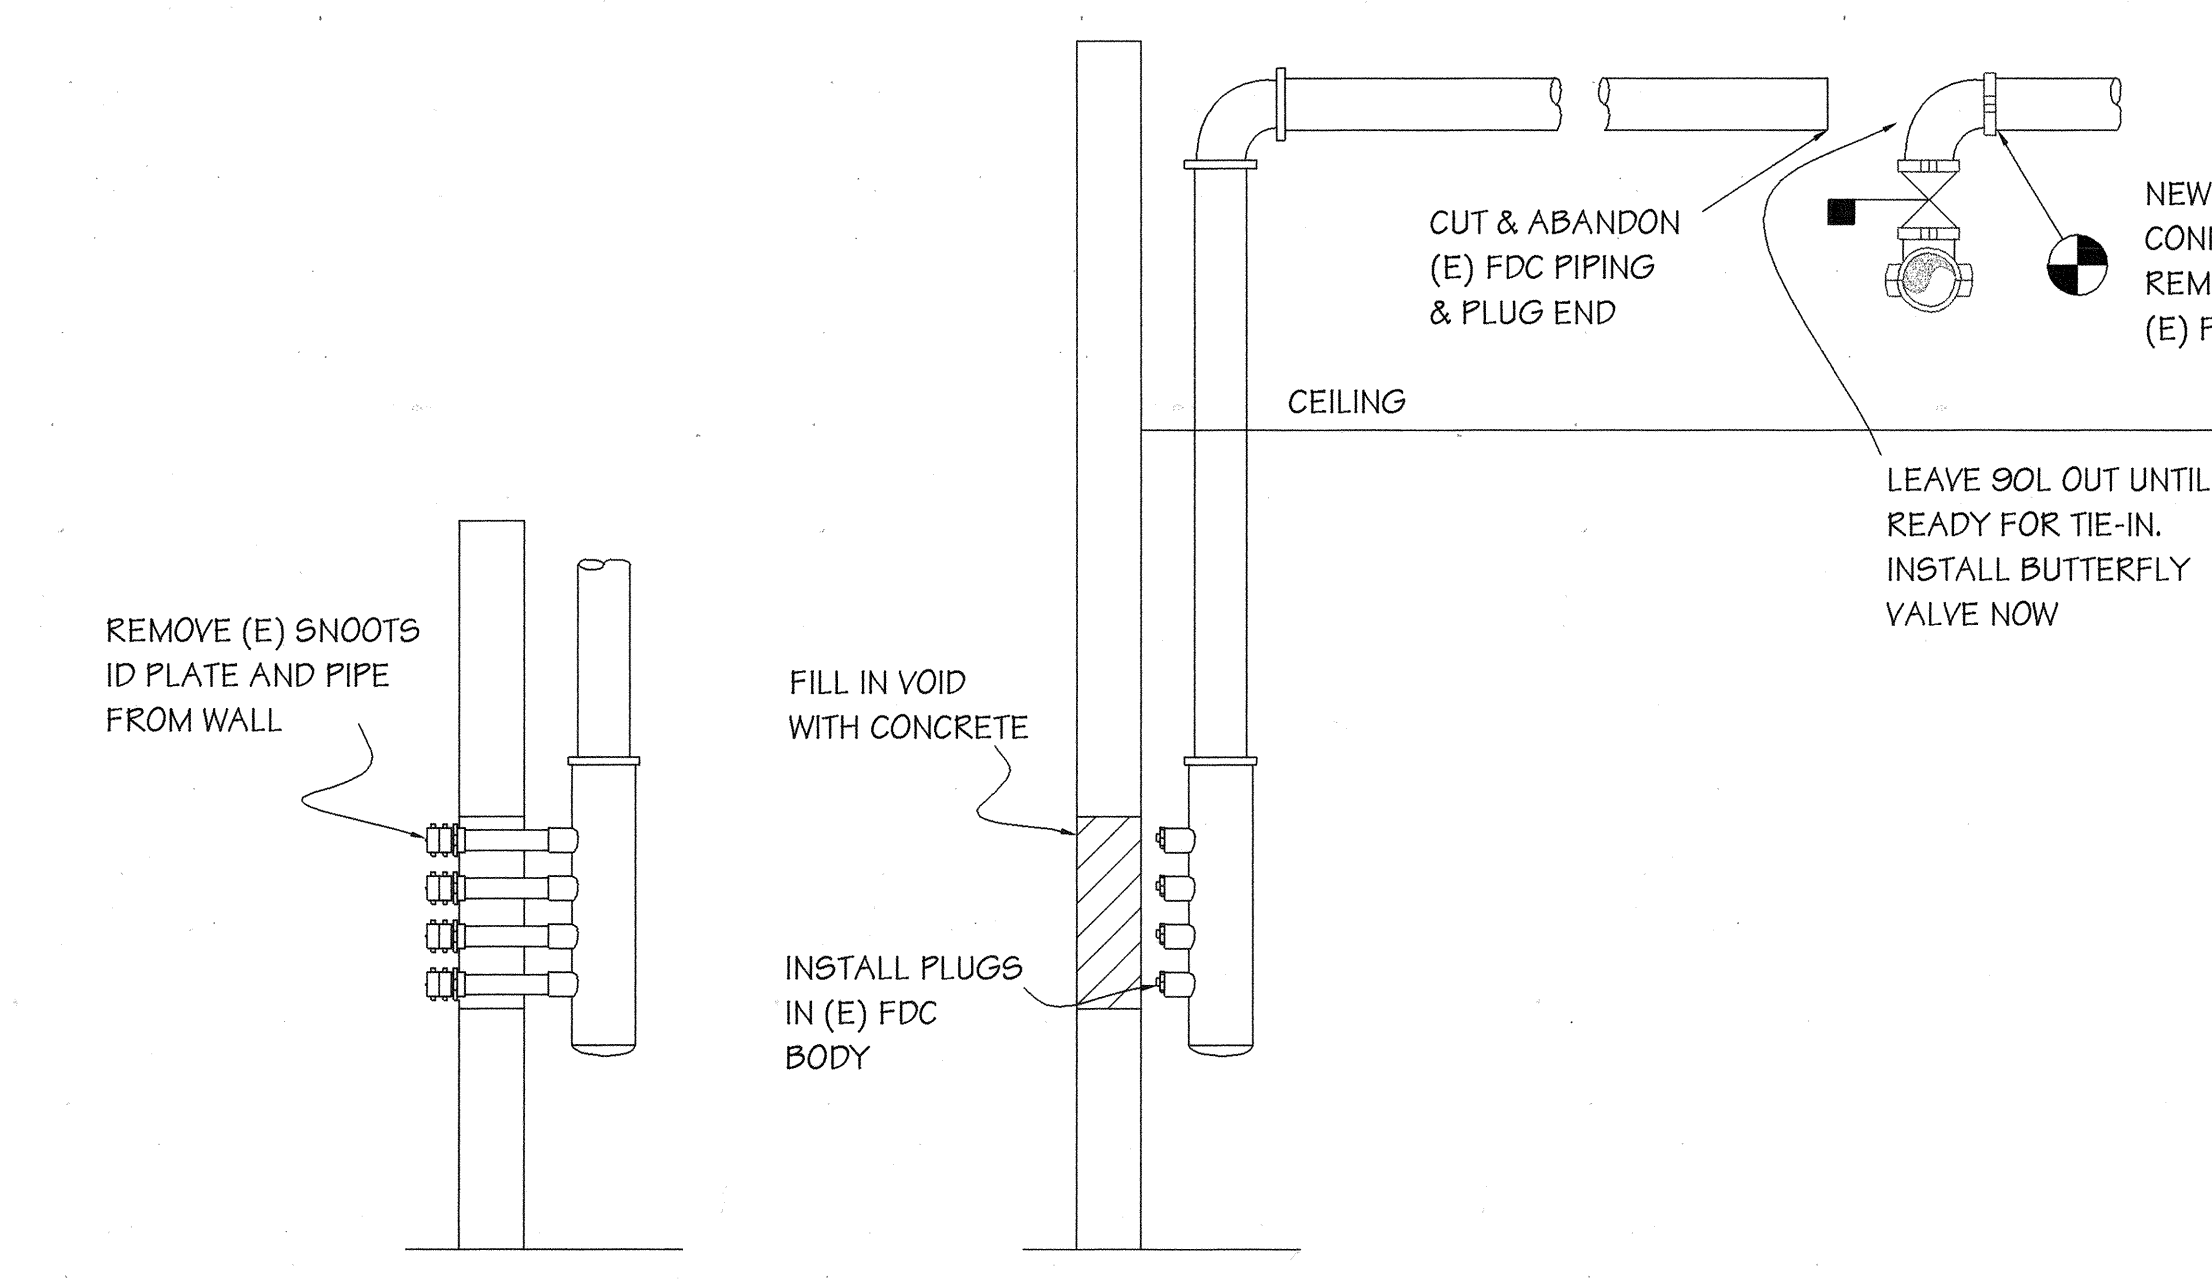


SECTION 1

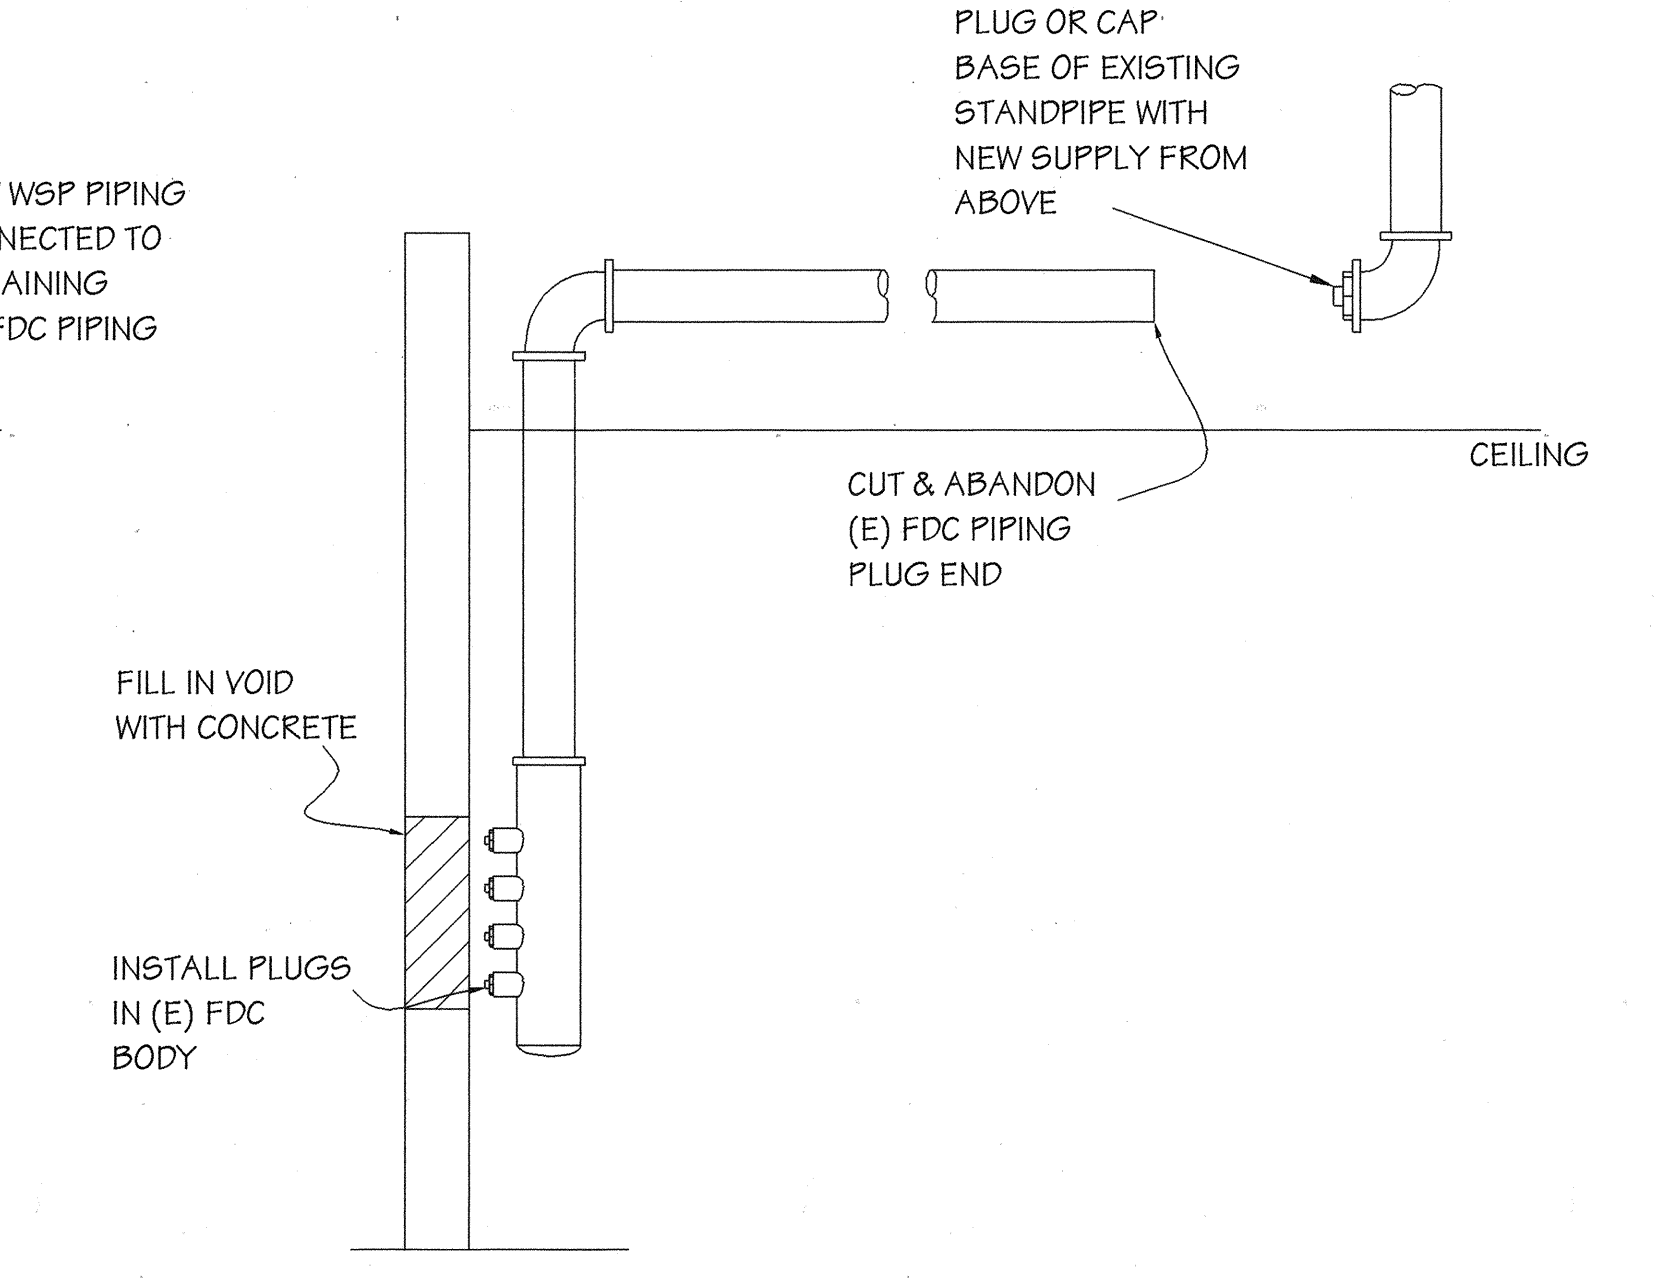


SECTION 4

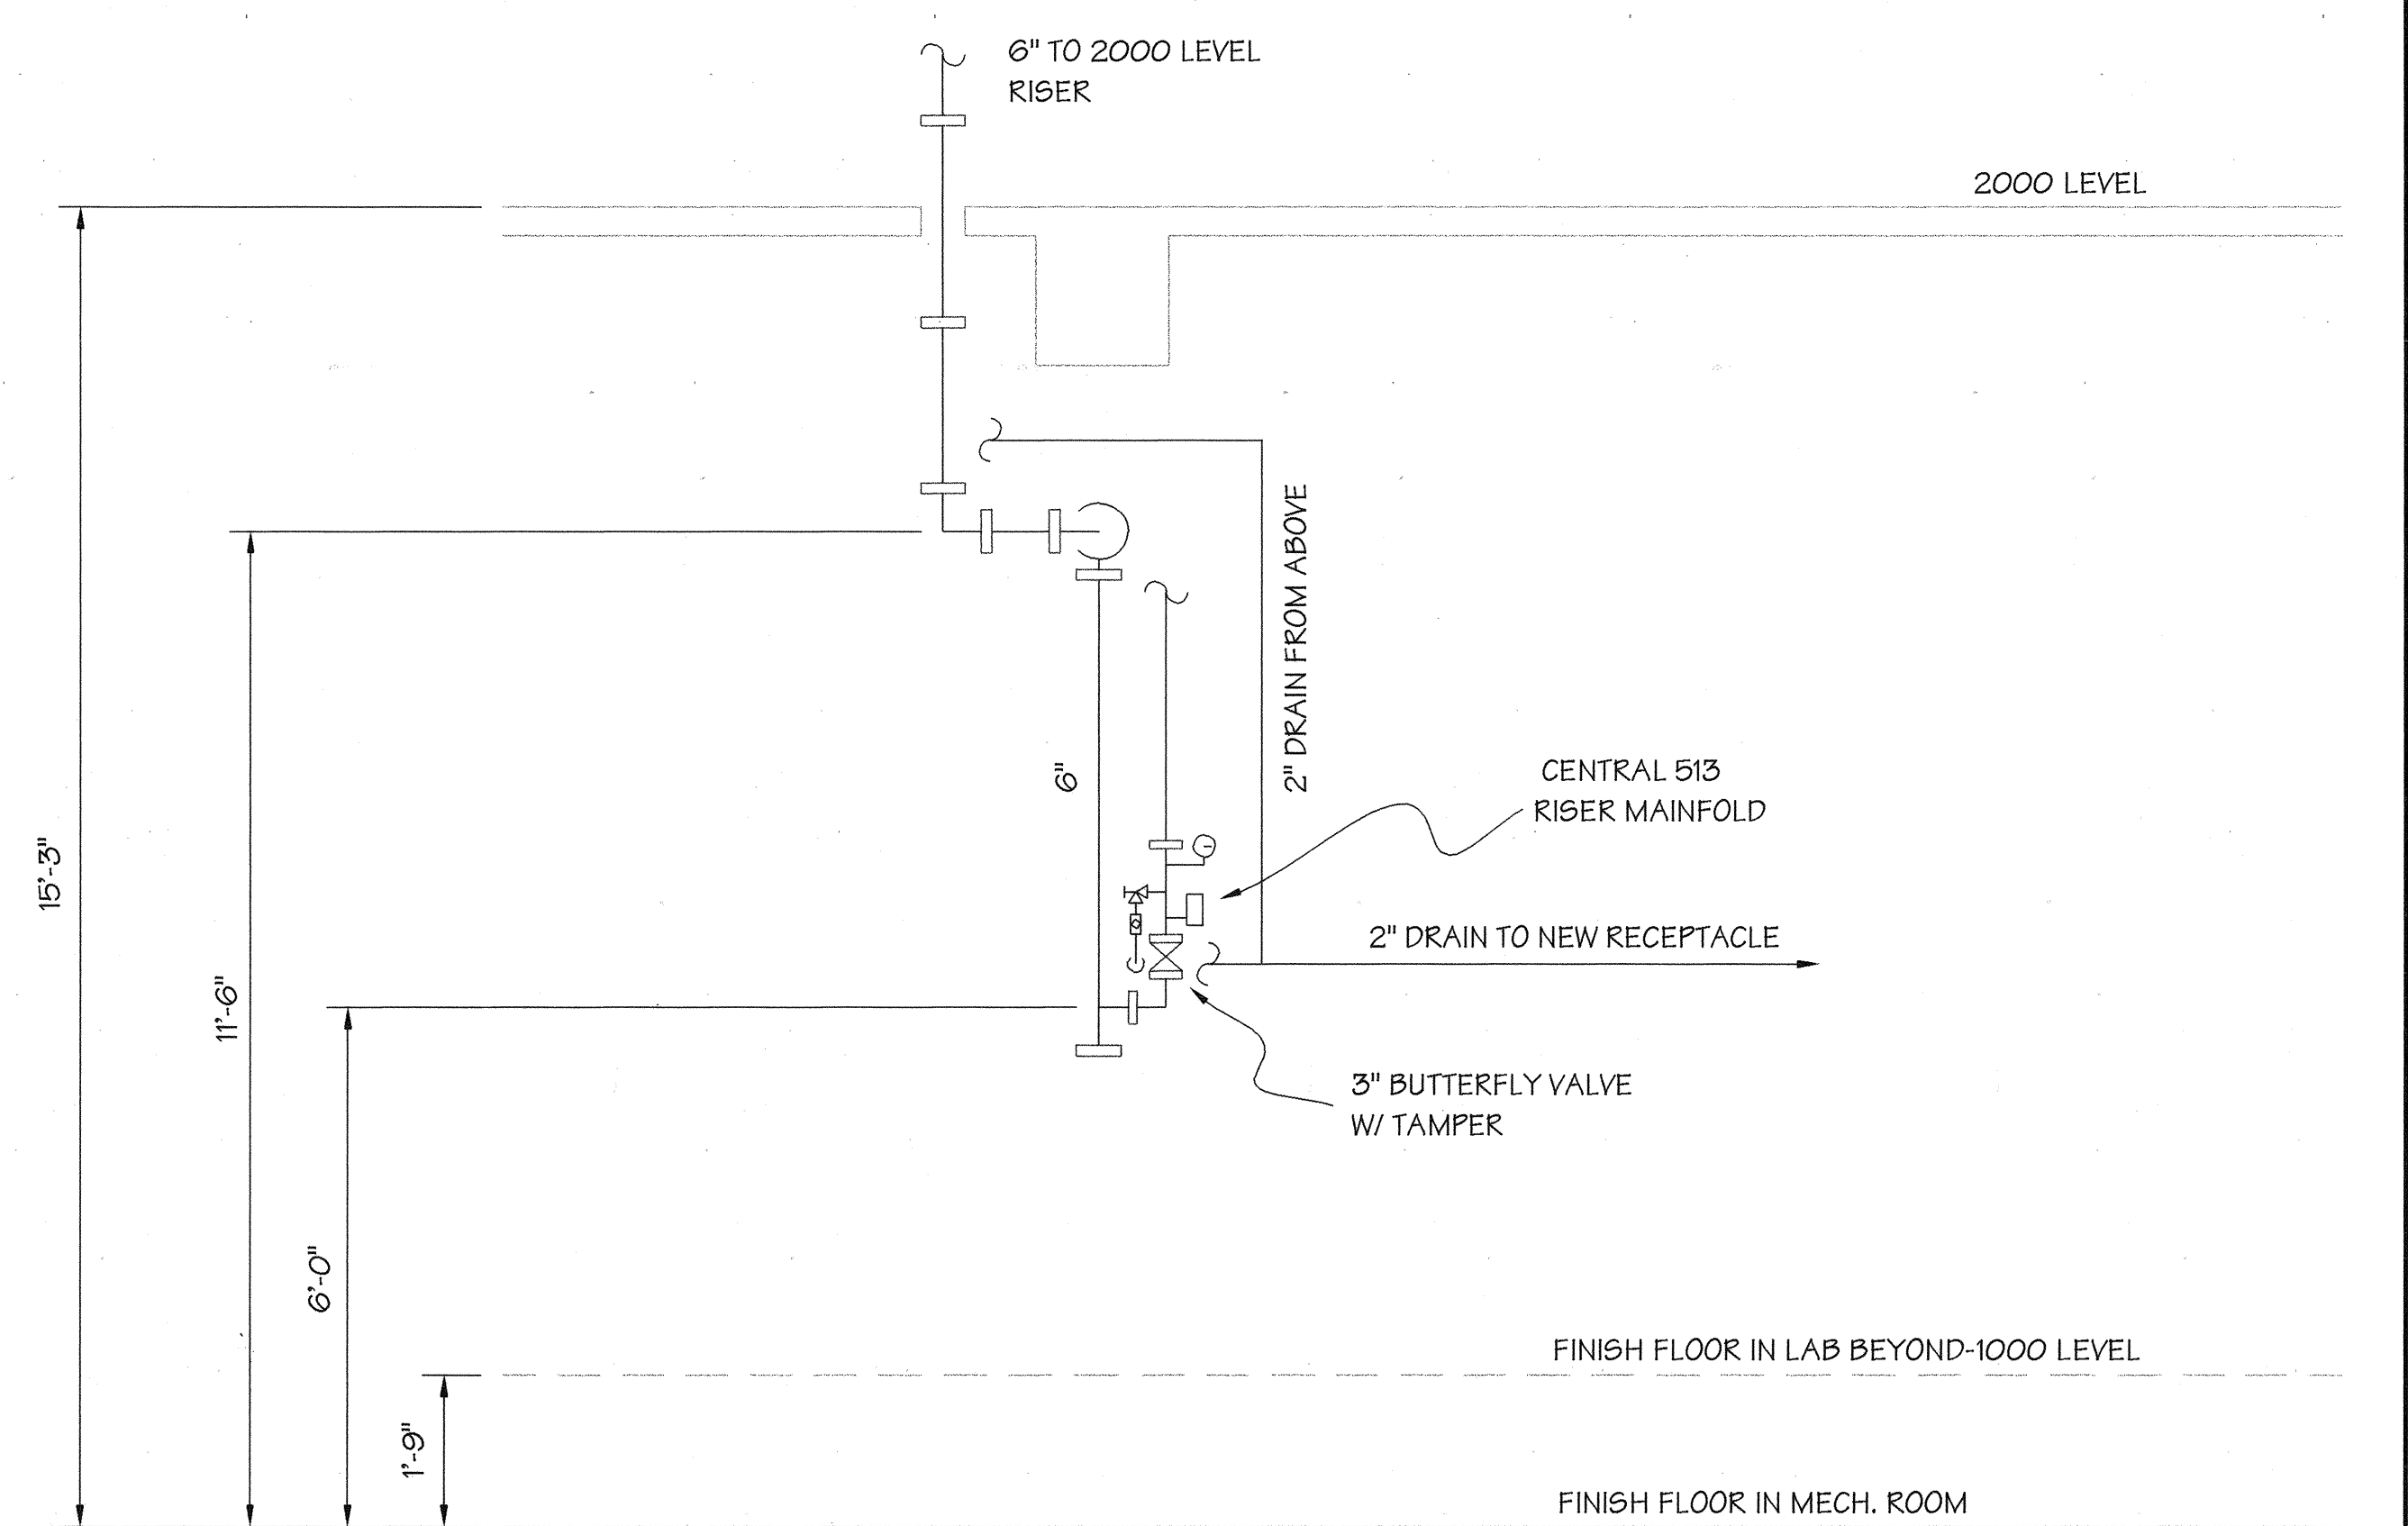



DETAIL OF MECHANICAL ROOM RISER

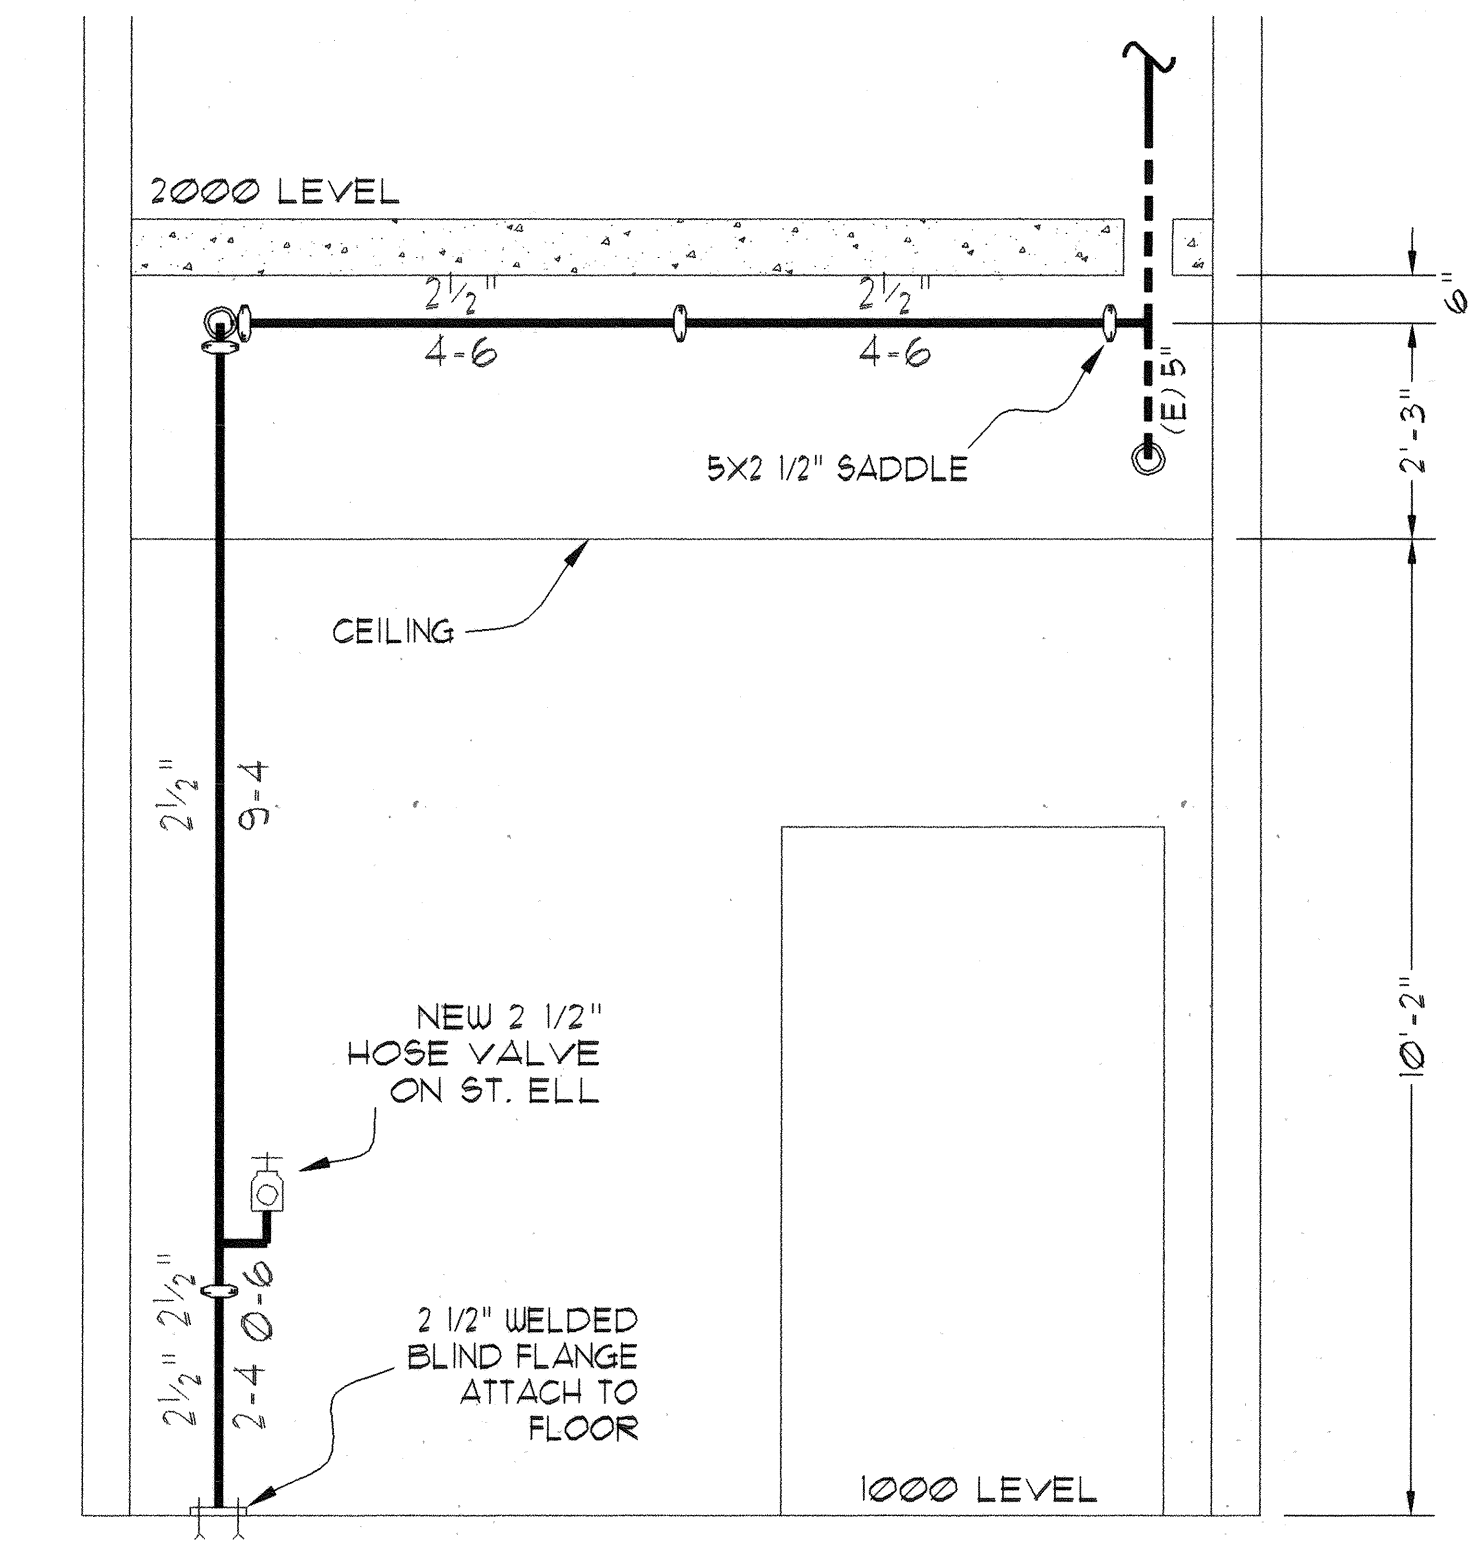

SECTION 2

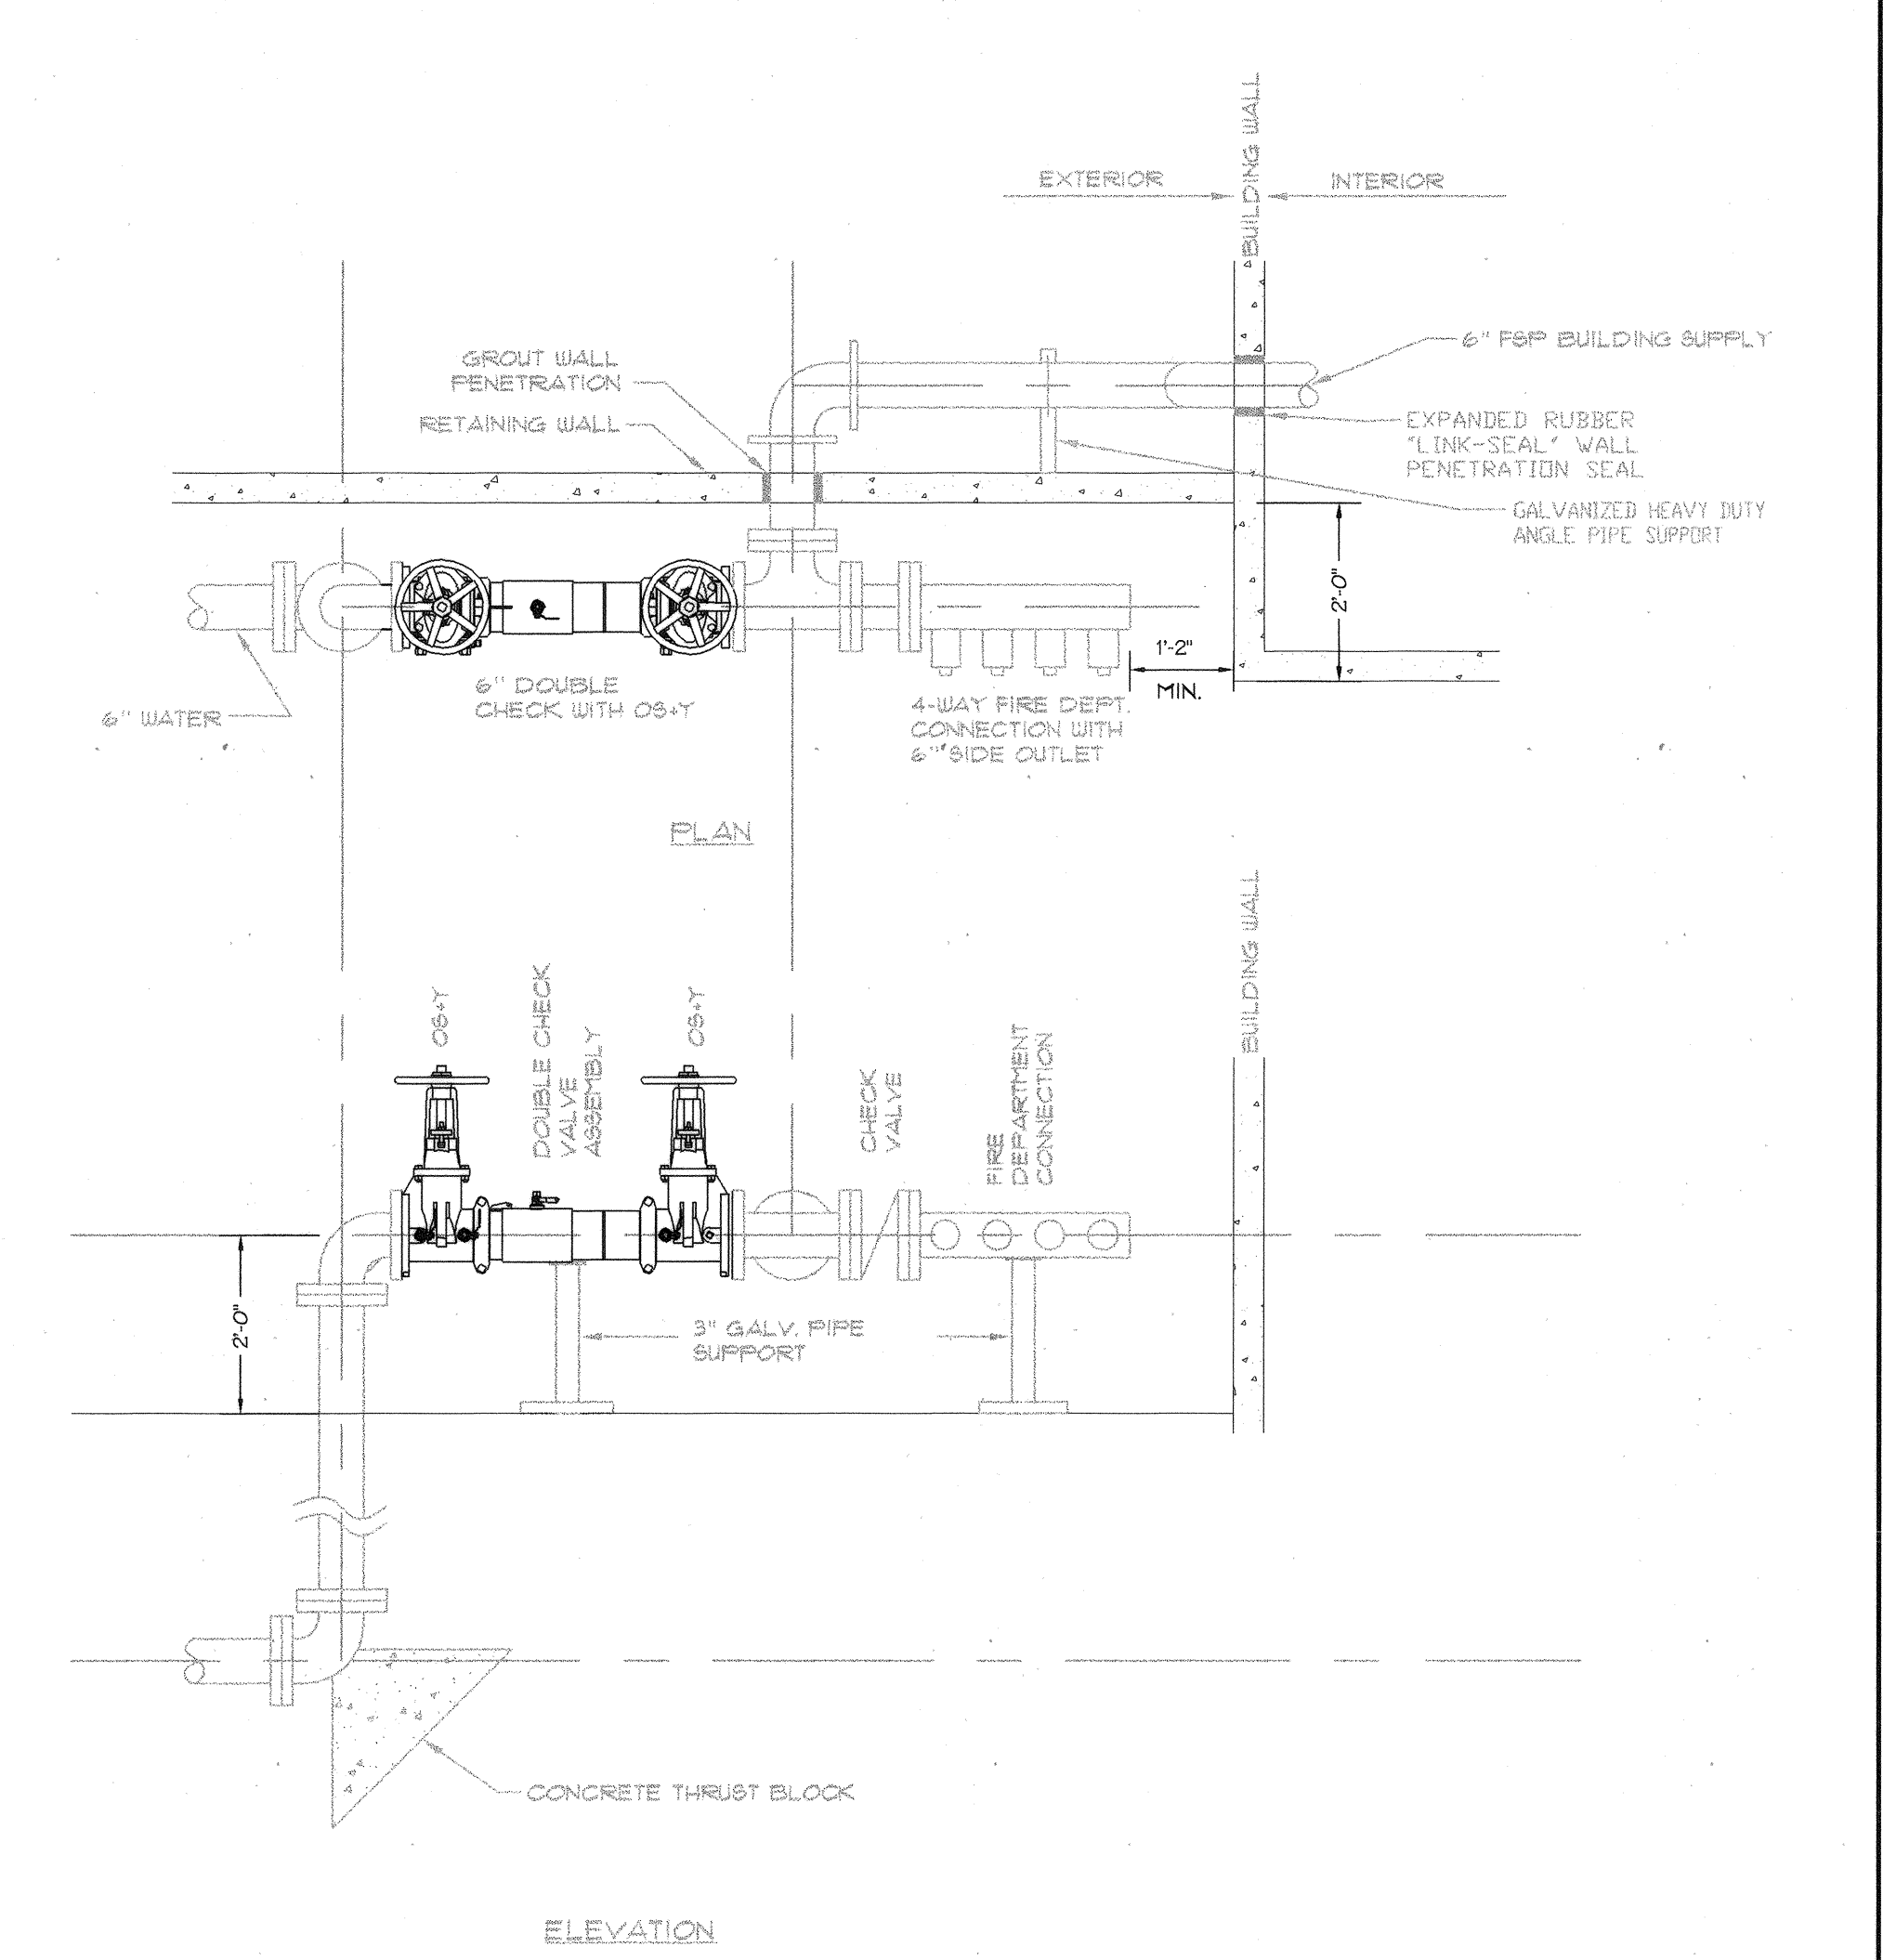

BOELTER HALL PIPING DETAIL A



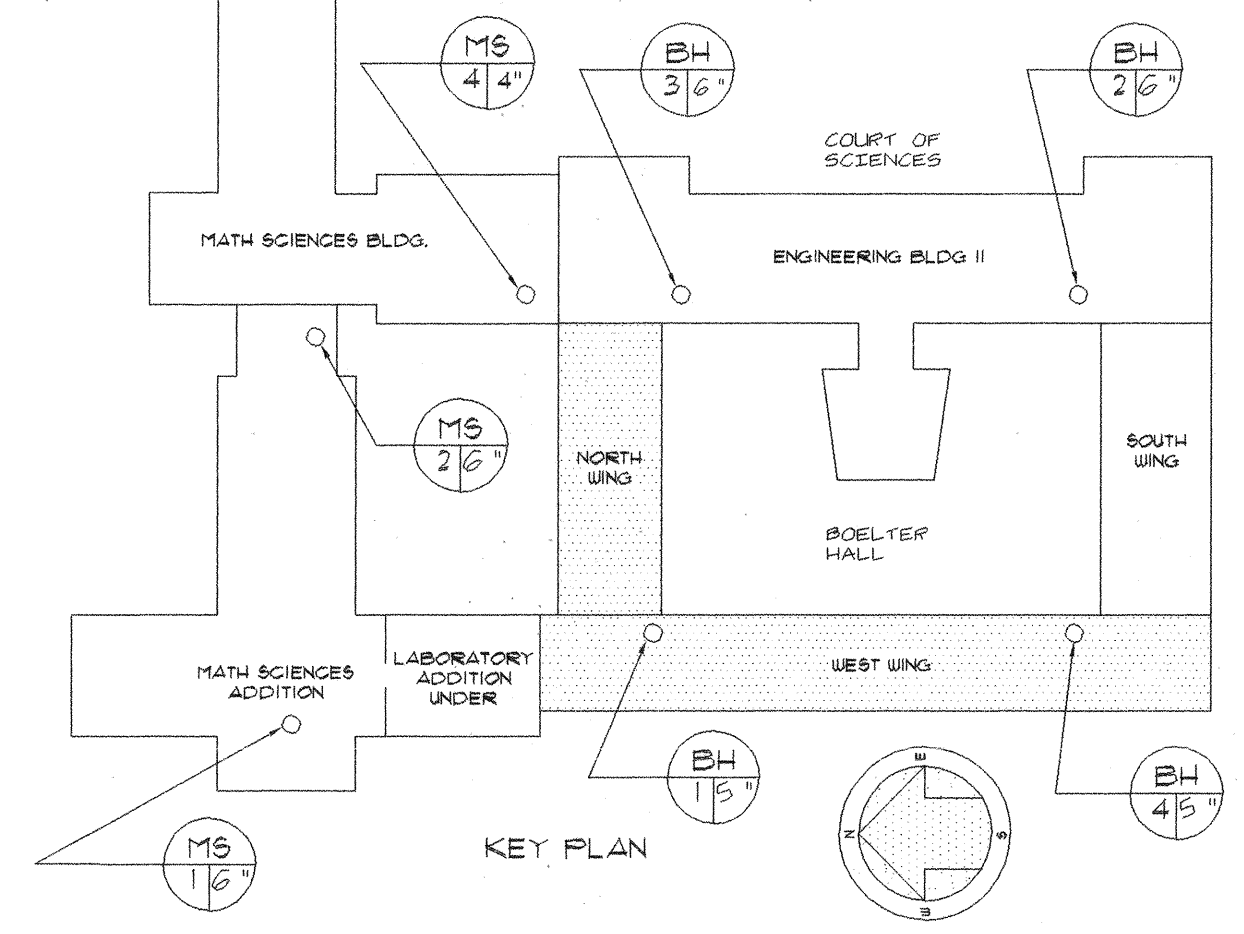
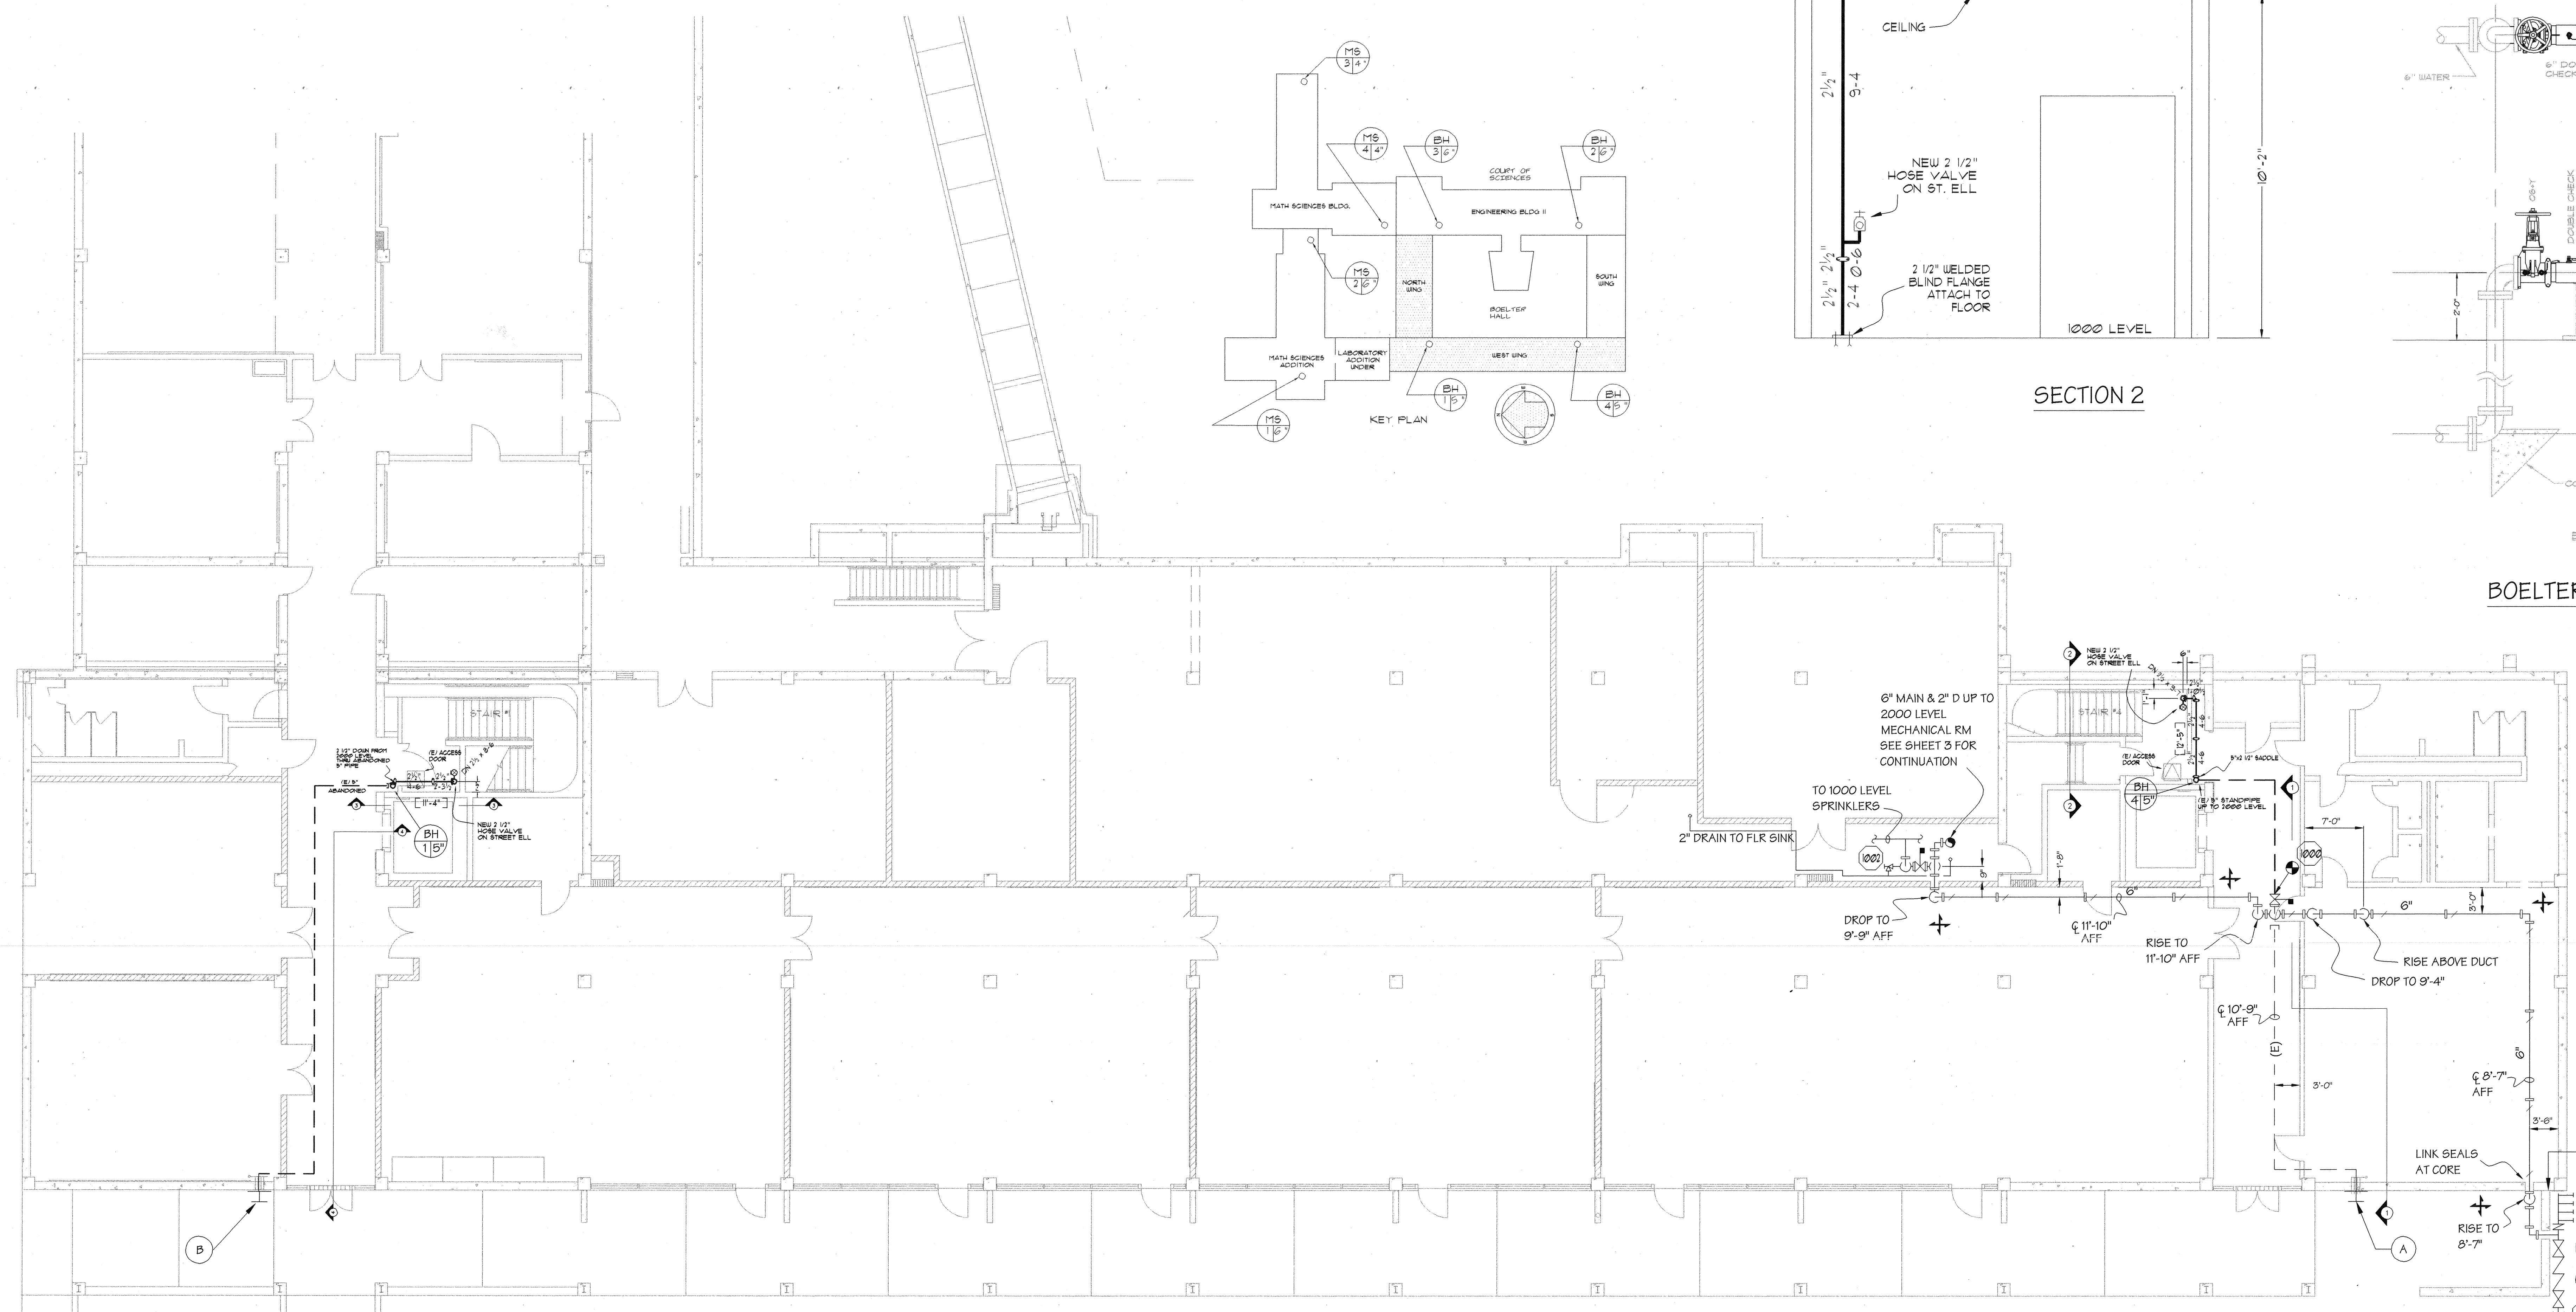


KEY PLAN

- (A) REMOVE EXISTING FIRE DEPARTMENT CONNECTION FOR BH #4 PER DETAIL 1.
- (B) REMOVE EXISTING FIRE DEPARTMENT CONNECTION FOR BH #1 PER DETAIL 2.
- (C) NEW 6" AMES 200(A) DOUBLE CHECK BACKFLOW ASSEMBLY AND 4-WAY FIRE DEPARTMENT CONNECTION. SEE DETAIL A.
- (D) BUILDING IDENTIFICATION SIGN AND ALARM BELL MOUNTED ON WALL AT 8'-0" ABOVE GRADE. SEE SHEET 1 FOR SIGN DETAILS.
- (E) POINT OF CONNECTION TO EXISTING 8" WATER MAIN WITH D.I. TEE.

AS BUILT
UCLA PROJECT NO. 346231/01

AUTOMATIC FIRE PROTECTION PLAN			
UCLA - BOELTER HALL FIRE SPRINKLER SYSTEM 1000 LEVEL WET STANDPIPE & UNDERGROUND			
OWNER	UCLA	BLDG. BH	DATE 10/27/04
CONTRACTOR	DIRECT	DESIGN 1000	DRAWN BY JDB
JOB NO.	04-11	DATE'S NOTED	APPROVED BY
LINK-NILSEN CORPORATION		SHEET NO.	
2 OF 26		LICENSE C-162-275822	

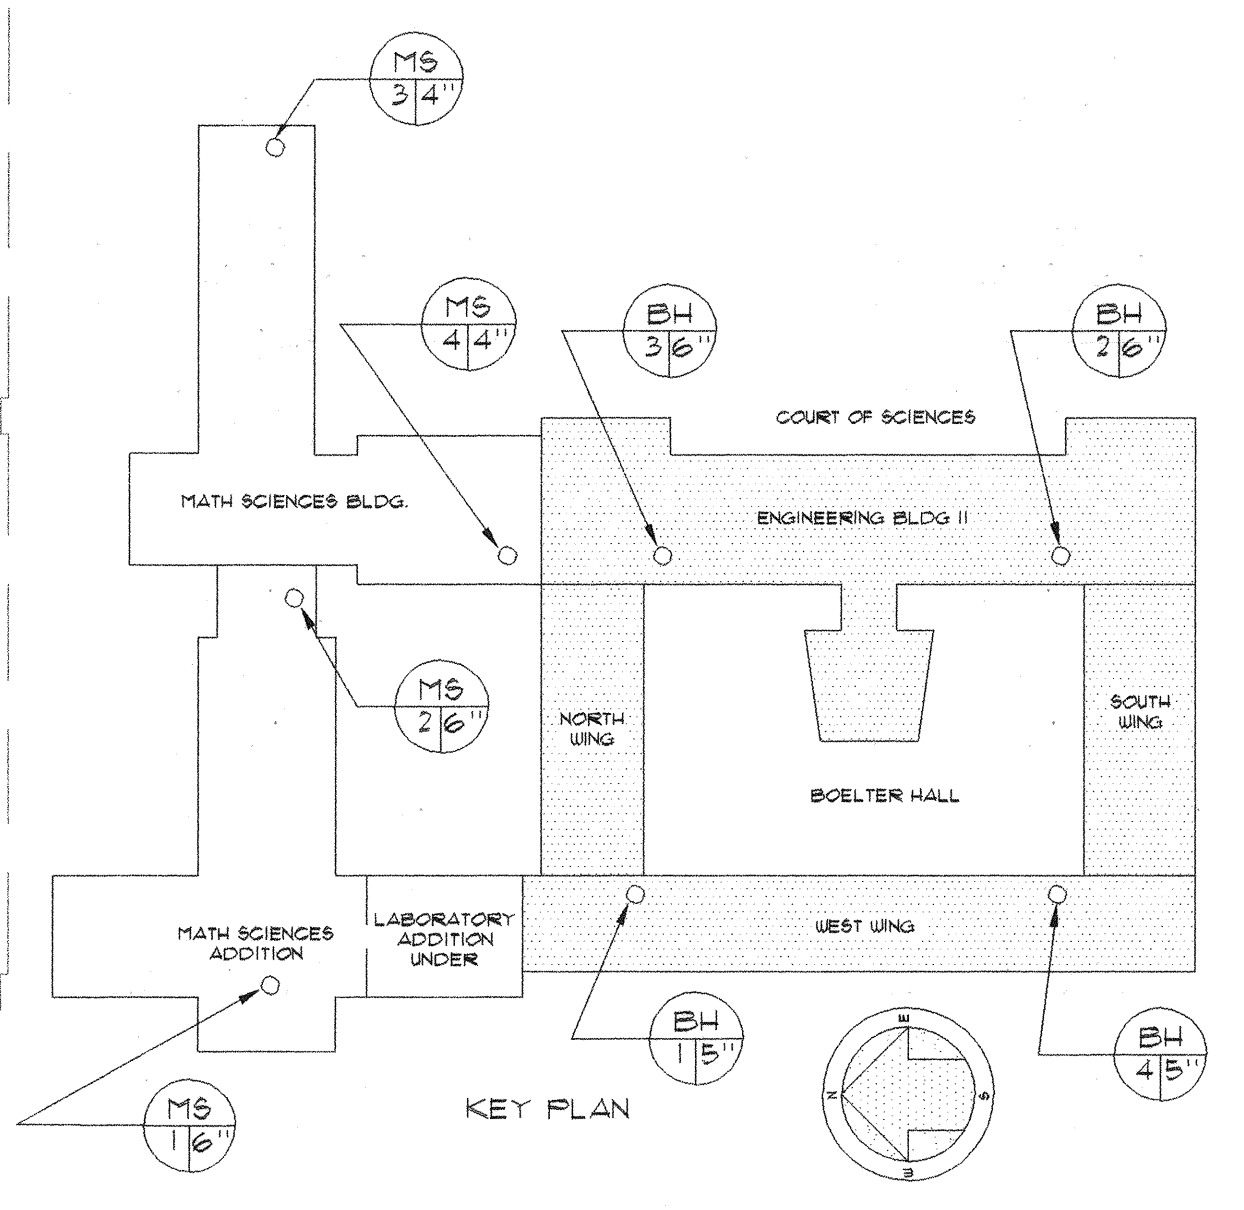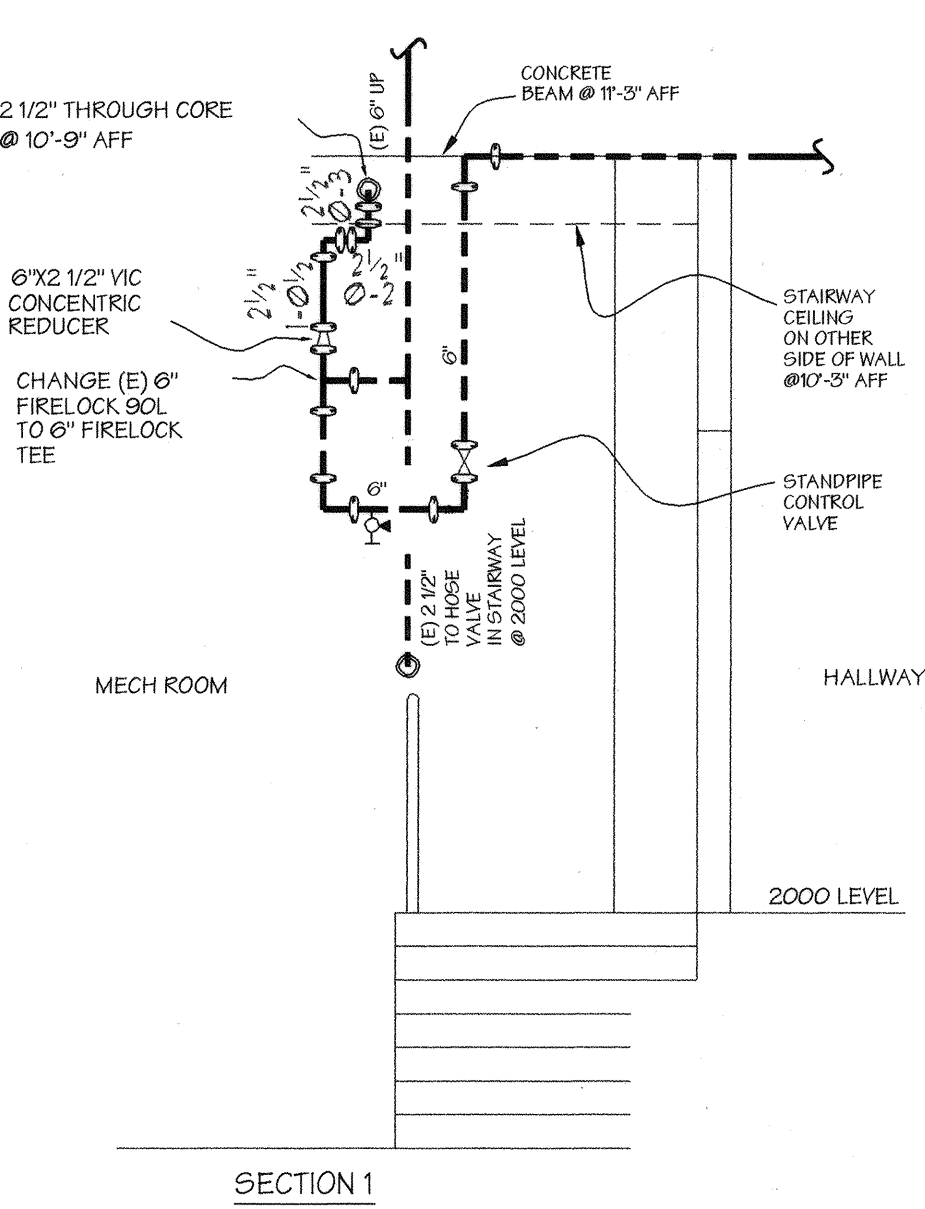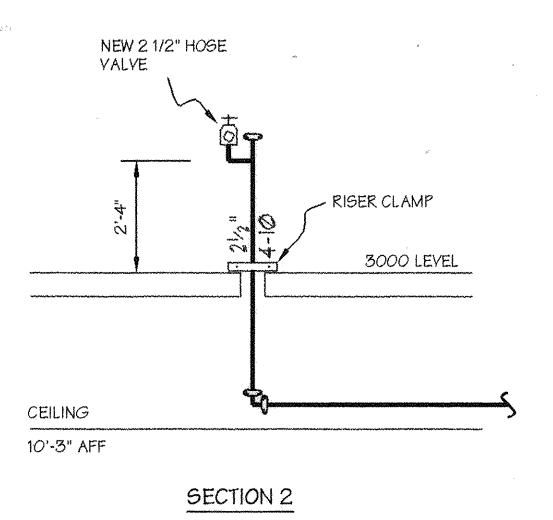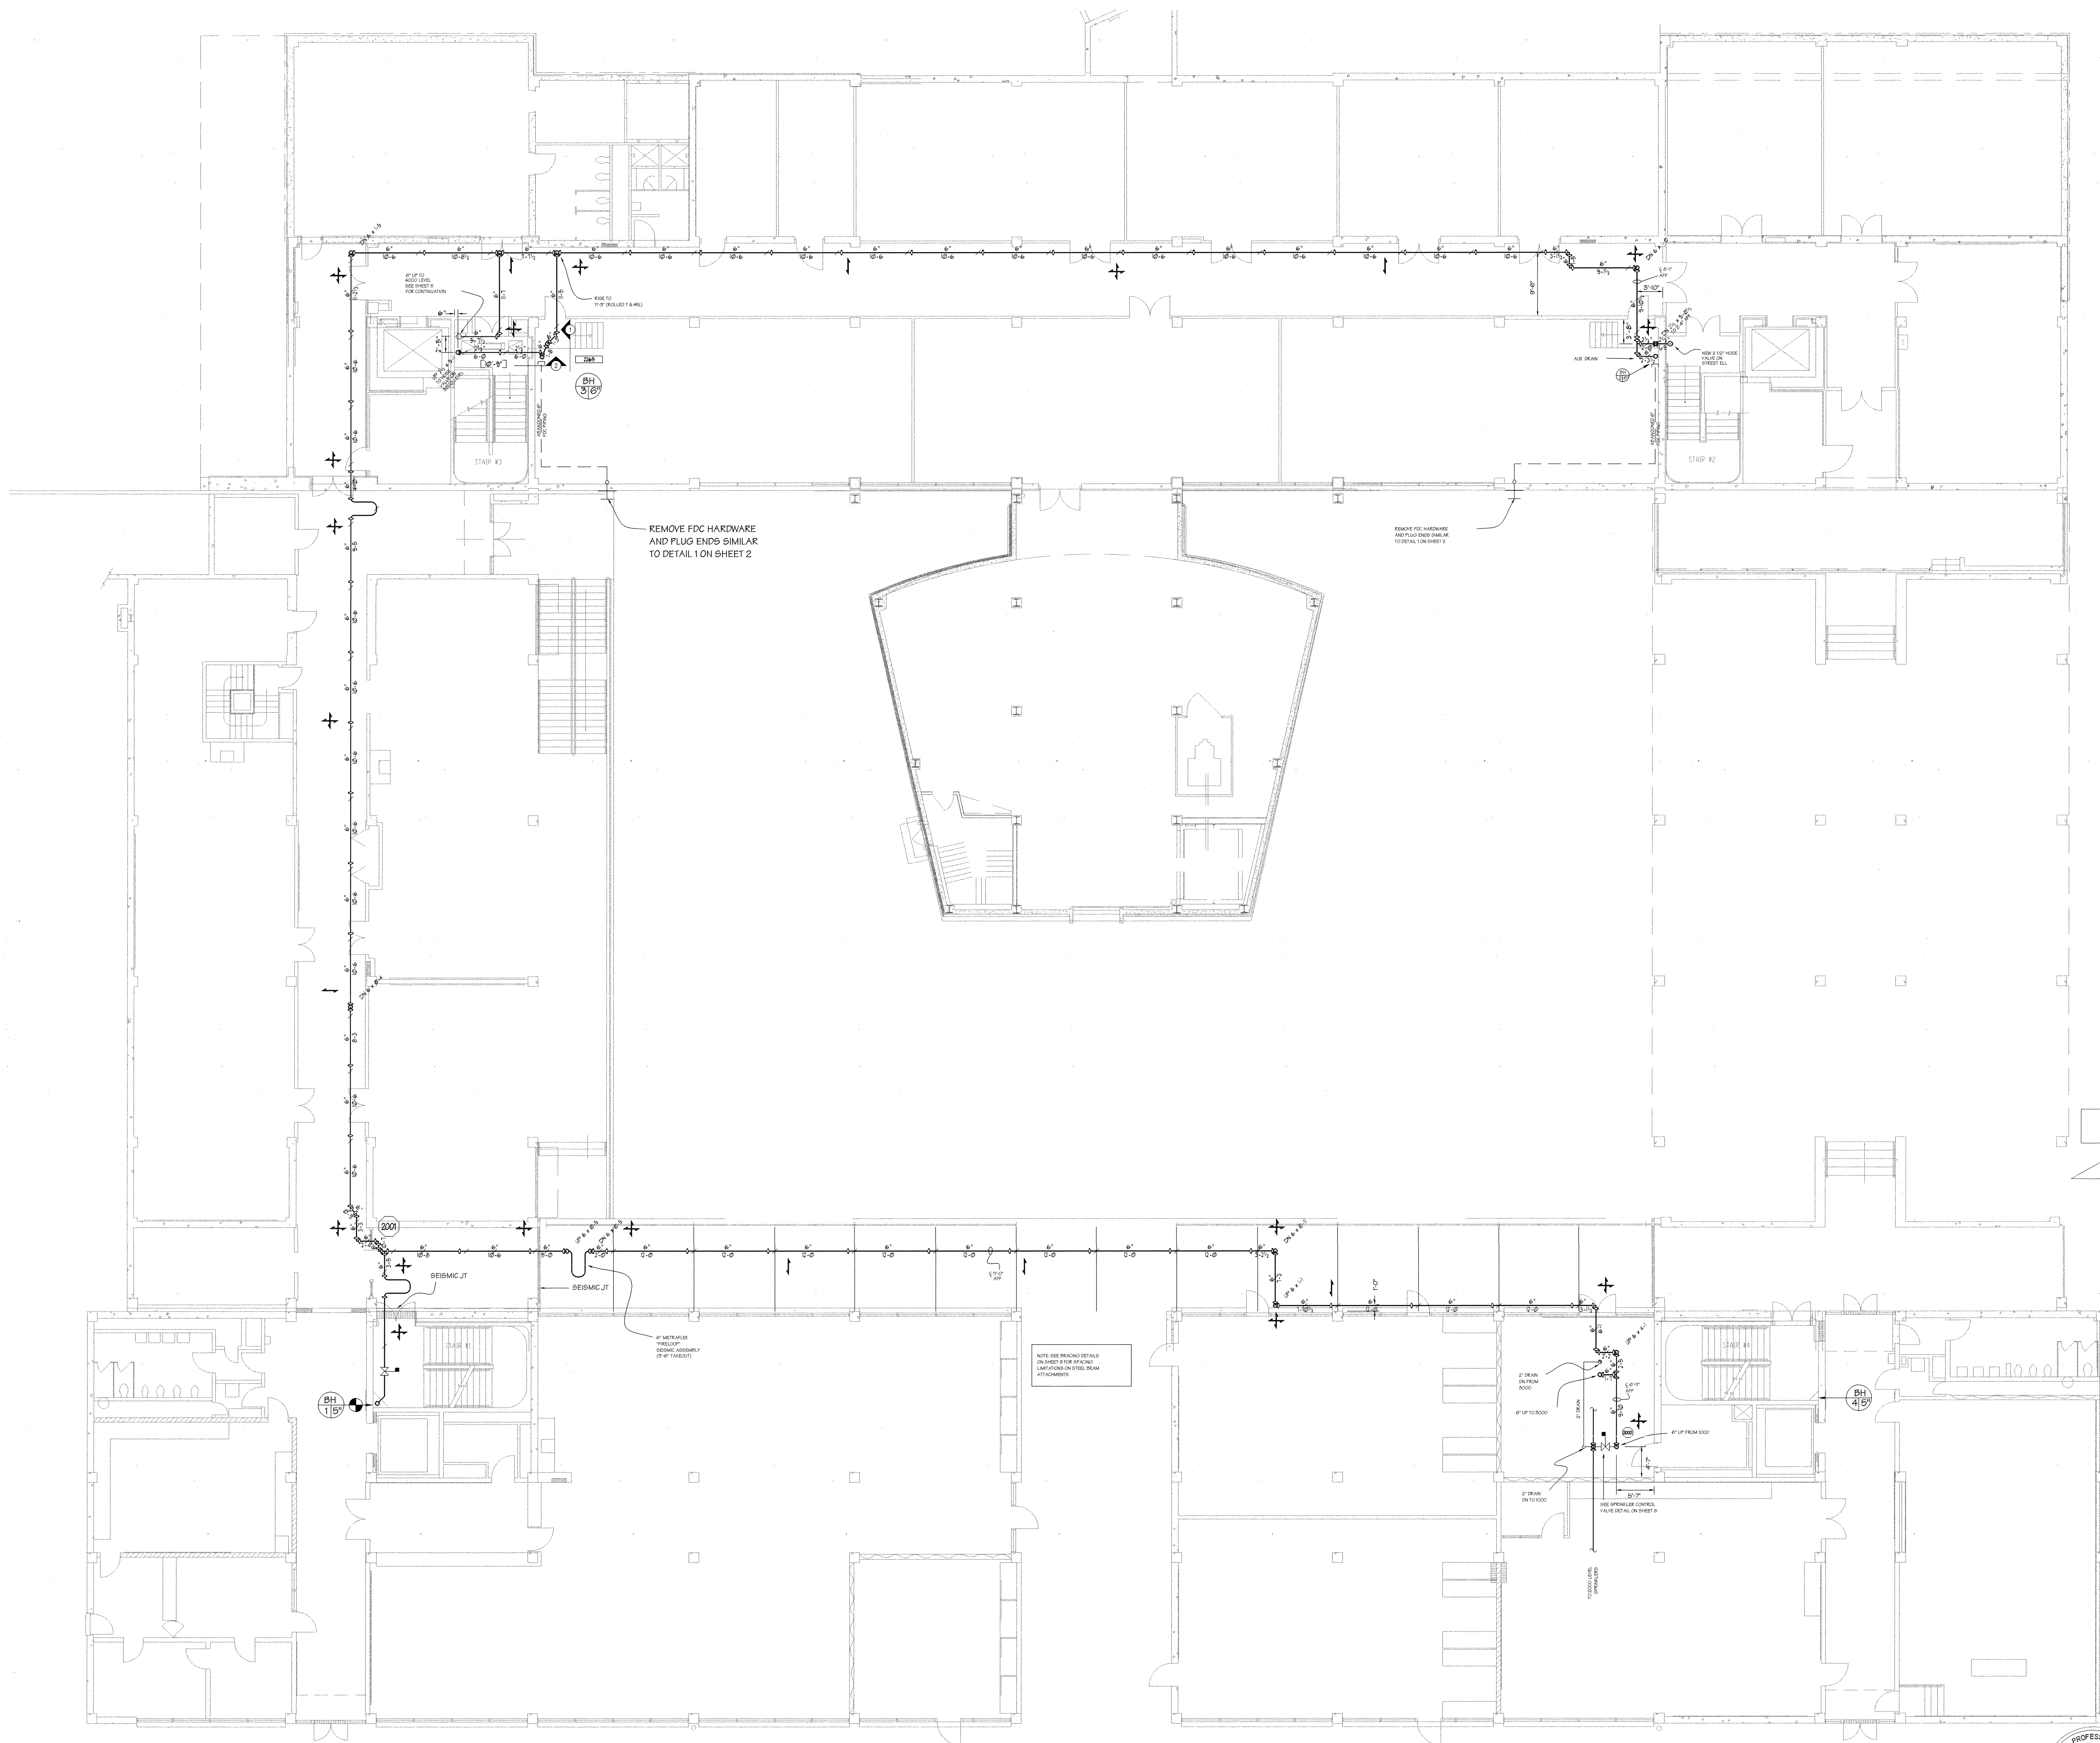




NOTE: SEE DRAINING DETAILS ON SHEET 8 FOR OF ACING LAYOUTS IN STEEL FLOOR ATTACHMENTS

6\"/>


AS BUILT
UCLA PROJECT NO. 946231.01

AUTOMATIC FIRE PROTECTION PLAN			
UCLA - BOELTER HALL FIRE SPRINKLER SYSTEM			
2000 LEVEL WET STANDPIPE- BOELTER HALL			
OWNER: UCLA	BLDG: BH	DATE: 10/27/04	DESIGN BY: ESB
CONTRACTOR: DIRECT	SCALE: AS NOTED	APPROVED BY:	
JOB NO. 04-11	LINK-NILSEN CORPORATION	SHEET NO. 3 OF 26	

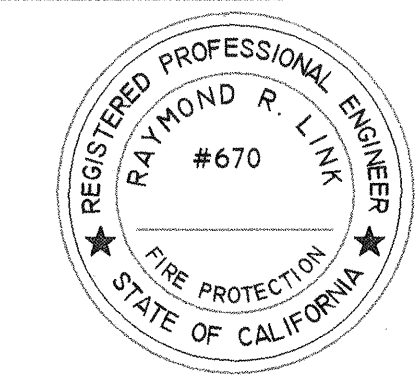

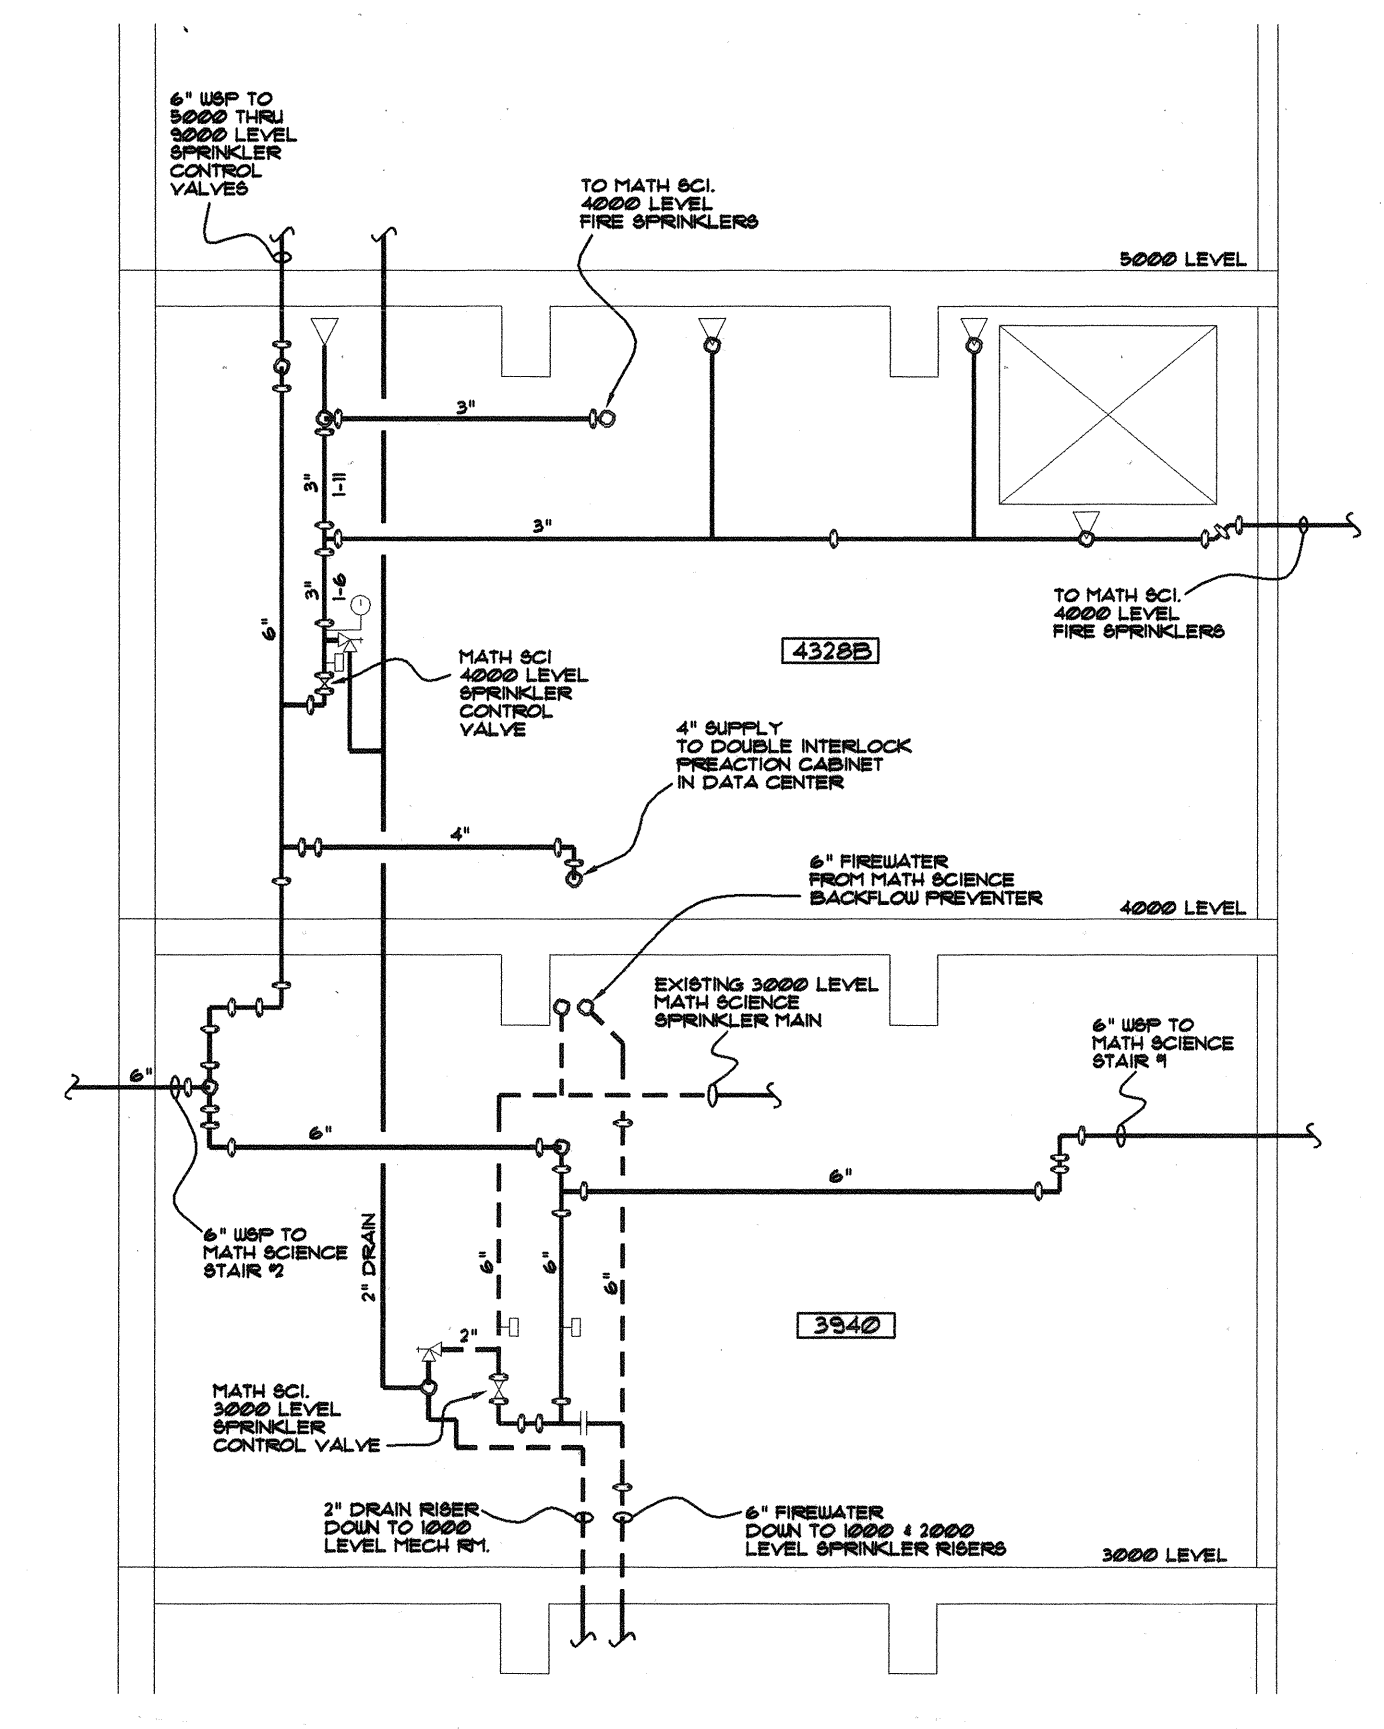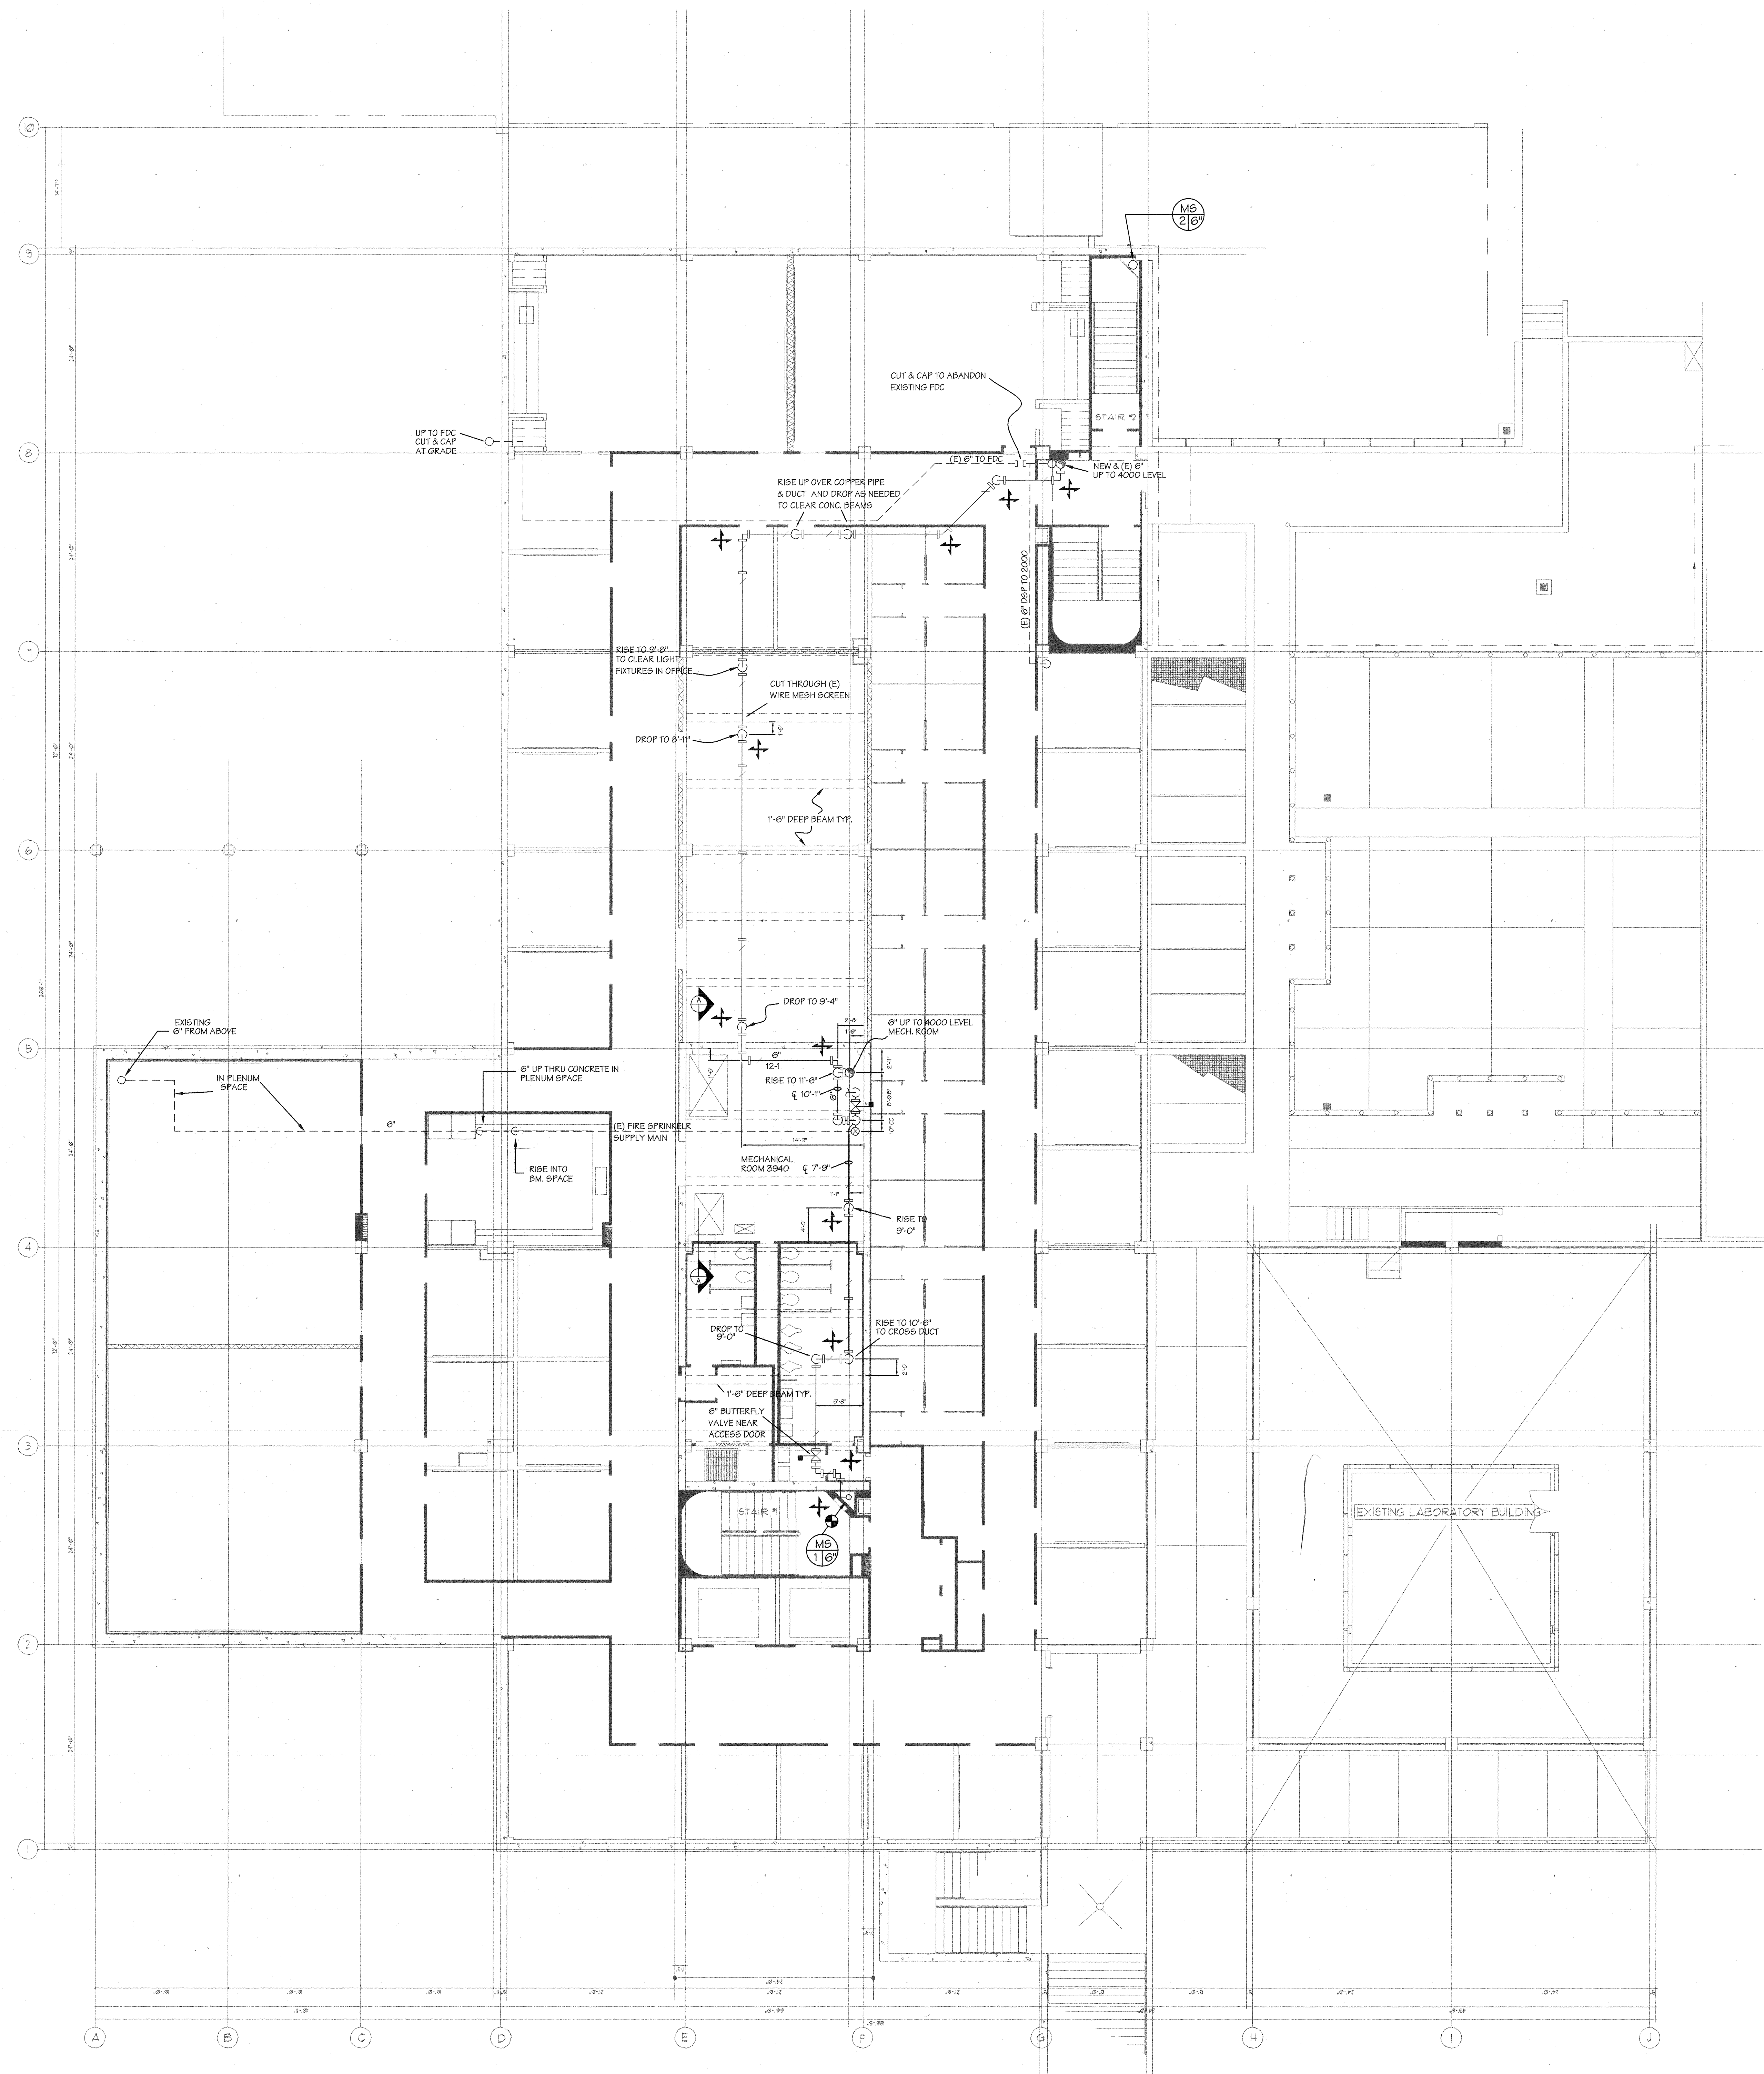

SECTION A-A

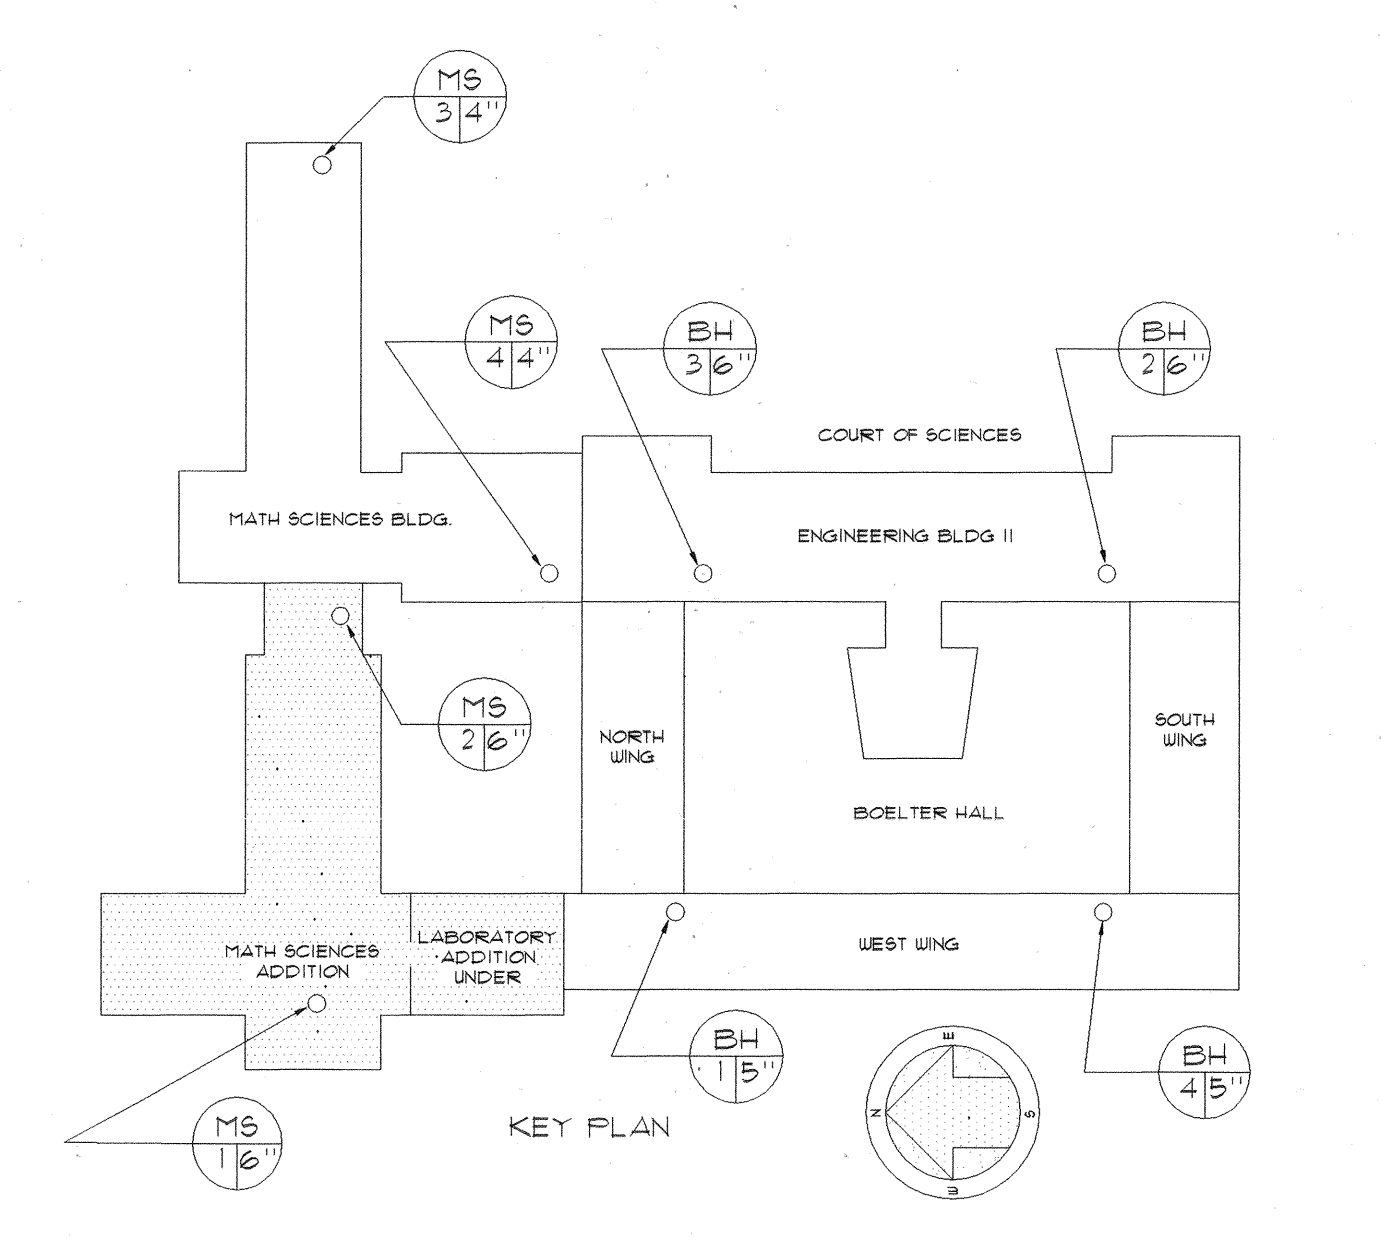


AS BUILT
UCLA PROJECT NO. 946237.01




AUTOMATIC FIRE PROTECTION PLAN
UCLA - BOELTER HALL FIRE SPRINKLER SYSTEM
3000 LEVEL WET STANDPIPE - MATH SCIENCES

OWNER: UCLA	INSG: BH	DATE: 10/27/04
CONTRACTOR: DIRECT	DRAWN BY: RBH	SCALE: 1/8" = 1'-0"
JOB NO. 04-11	APPROVED BY: LINK-NILSEN CORPORATION	SHEET NO. 4 OF 26

LINK-NILSEN CORPORATION
13750 JENNY HOLLOW DRIVE, SUITE 100, SAN DIEGO, CA 92126
TEL: 619-444-1111 FAX: 619-444-1112
WWW.LINK-NILSEN.COM

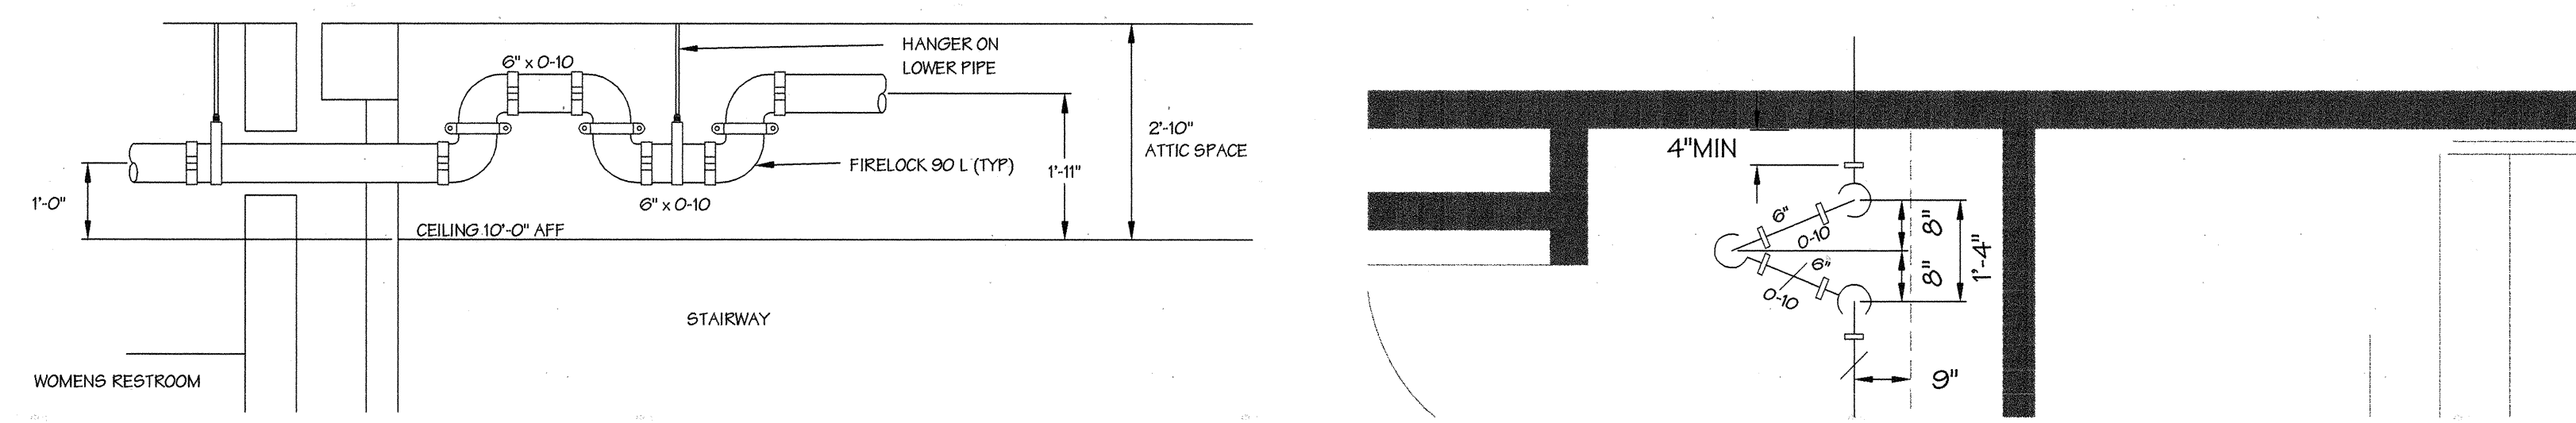


SEISMIC SEPARATION ASSEMBLY-PLAN VIEW

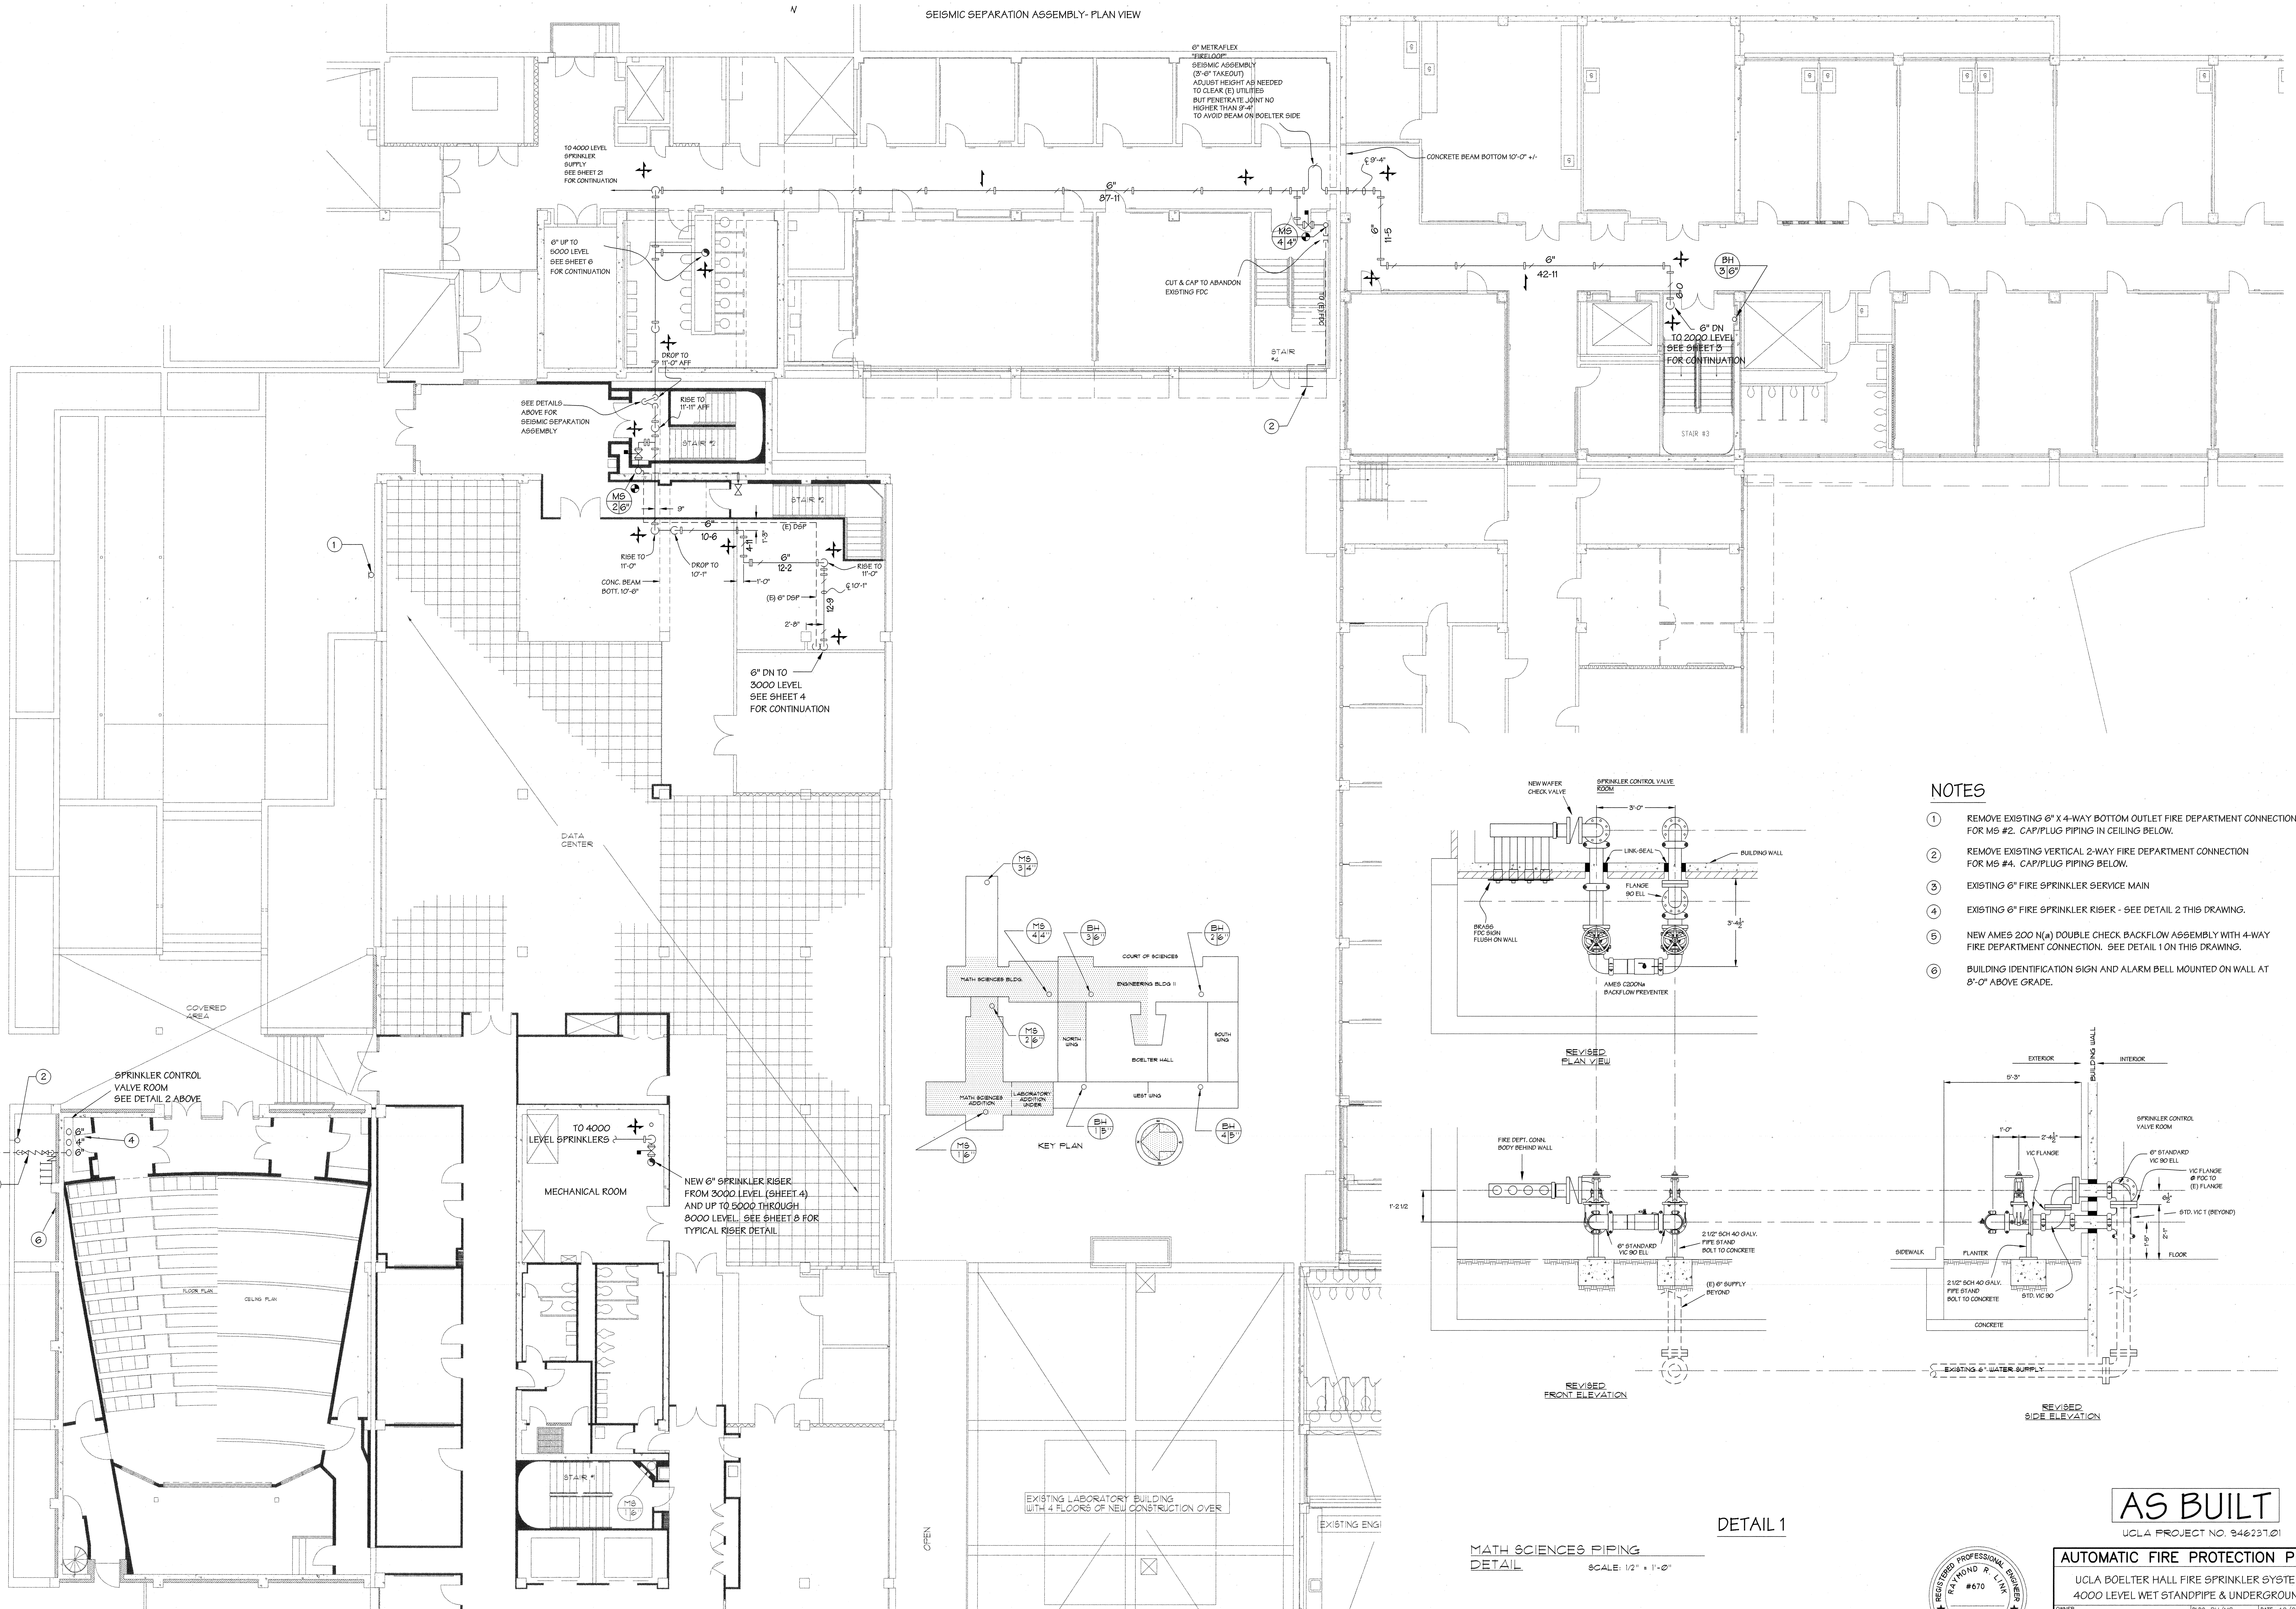


NOTES


- 1 REMOVE EXISTING 6" X 4-WAY BOTTOM OUTLET FIRE DEPARTMENT CONNECTION FOR MS #2. CAP/PLUG PIPING IN CEILING BELOW.
- 2 REMOVE EXISTING VERTICAL 2-WAY FIRE DEPARTMENT CONNECTION FOR MS #4. CAP/PLUG PIPING BELOW.
- 3 EXISTING 6" FIRE SPRINKLER SERVICE MAIN
- 4 EXISTING 6" FIRE SPRINKLER RISER - SEE DETAIL 2 THIS DRAWING.
- 5 NEW AMES 200 N(a) DOUBLE CHECK BACKFLOW ASSEMBLY WITH 4-WAY FIRE DEPARTMENT CONNECTION. SEE DETAIL 1 ON THIS DRAWING.
- 6 BUILDING IDENTIFICATION SIGN AND ALARM BELL MOUNTED ON WALL AT 8'-0" ABOVE GRADE.

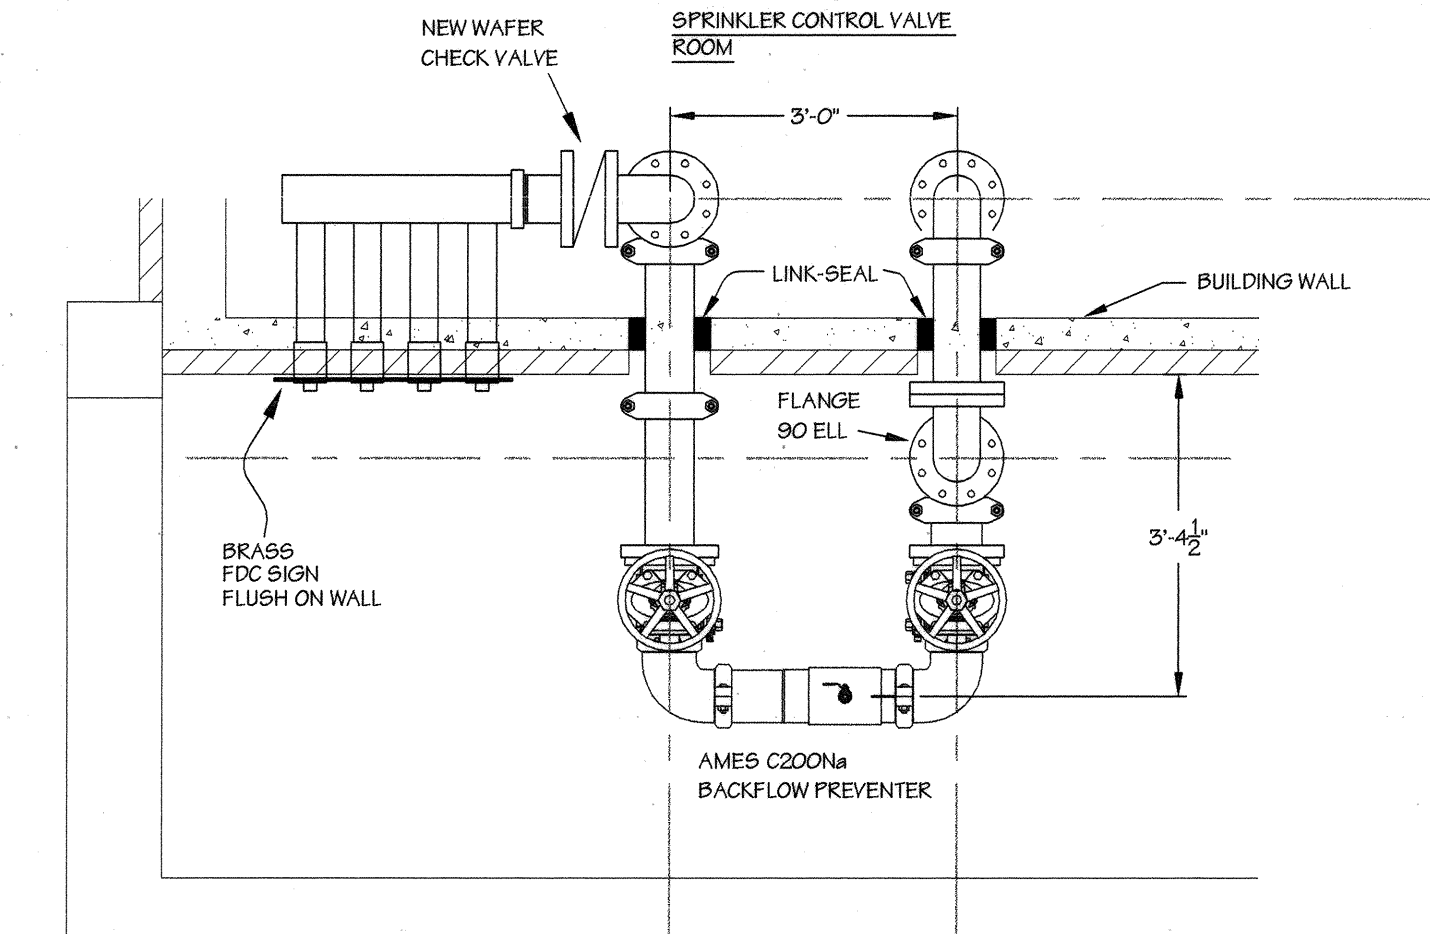

REVISED PLAN VIEW

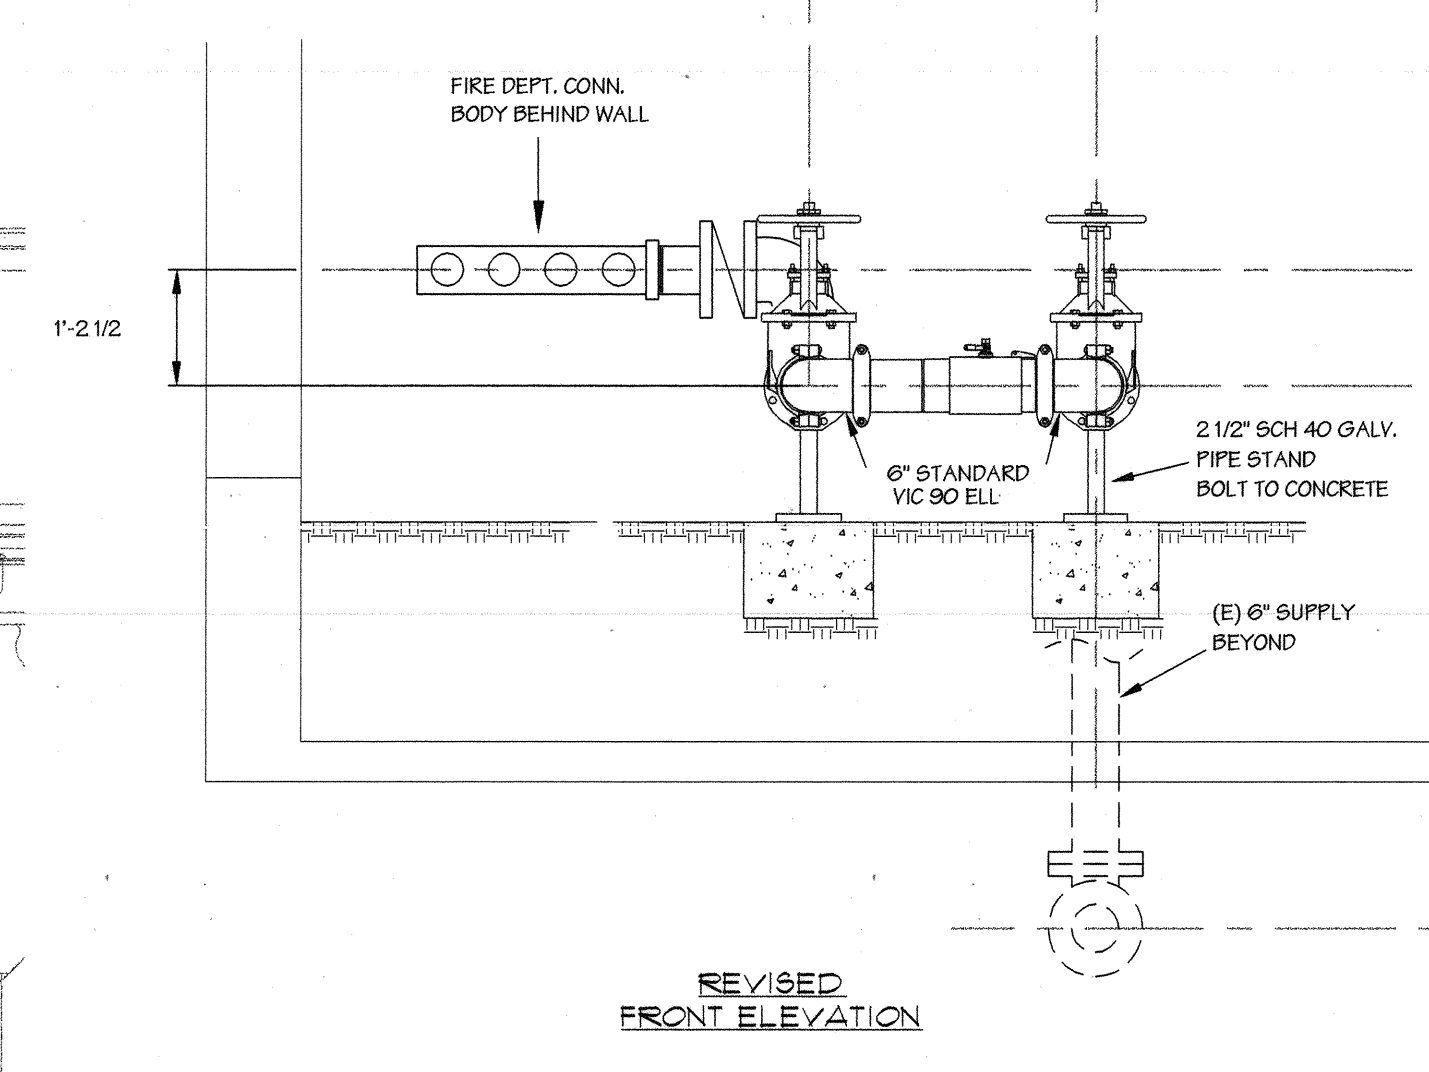

REVISED FRONT ELEVATION

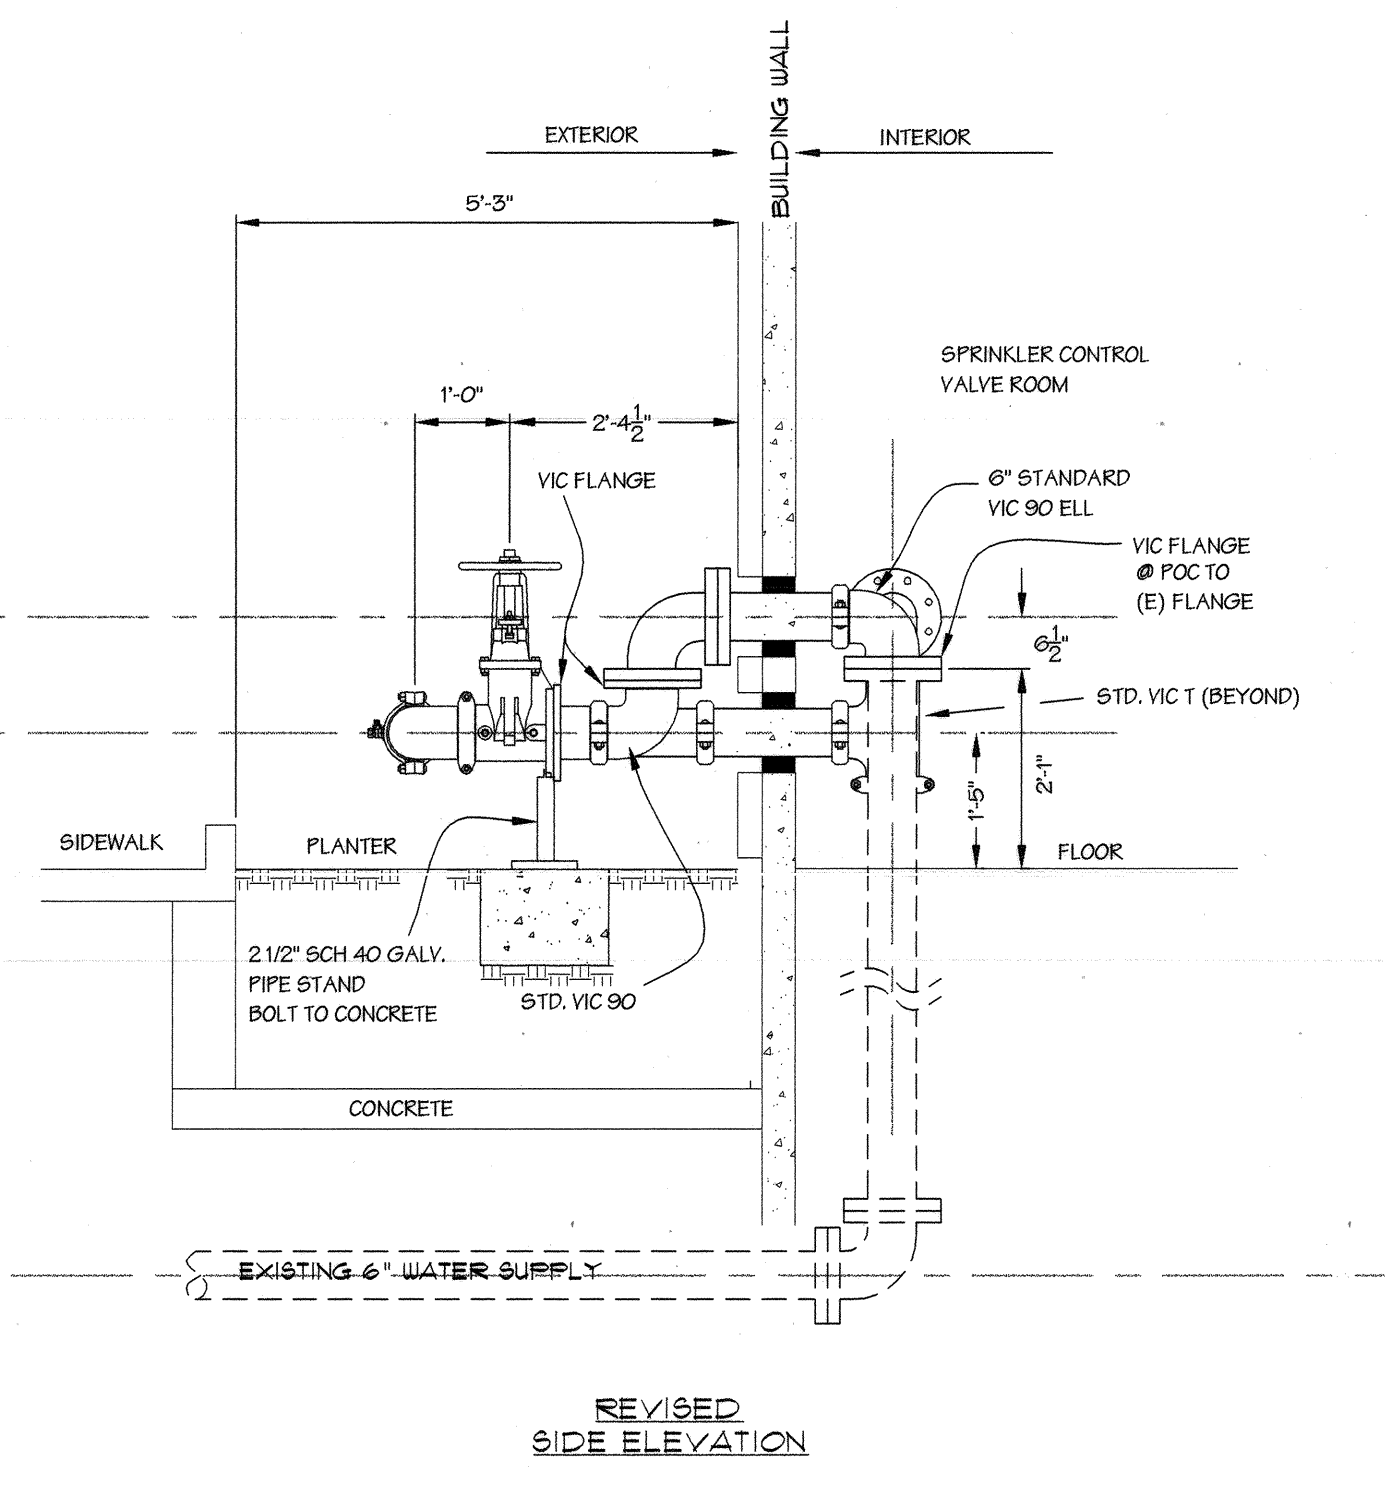

REVISED SIDE ELEVATION

MATH SCIENCES PIPING
DETAIL




DETAIL 1

AS BUILT
UCLA PROJECT NO. 946237.01

AUTOMATIC FIRE PROTECTION PLAN

UCLA BOELTER HALL FIRE SPRINKLER SYSTEM 4000 LEVEL WET STANDPIPE & UNDERGROUND			
OWNER	UCLA	DATE	10/27/04
CONTRACTOR	DIRECT	SCALE	1/8" = 1'-0"
JOB NO.	04-11	APPROVED BY	[Signature]
LINK-NILSEN CORPORATION		SHEET NO. 5 OF 26	



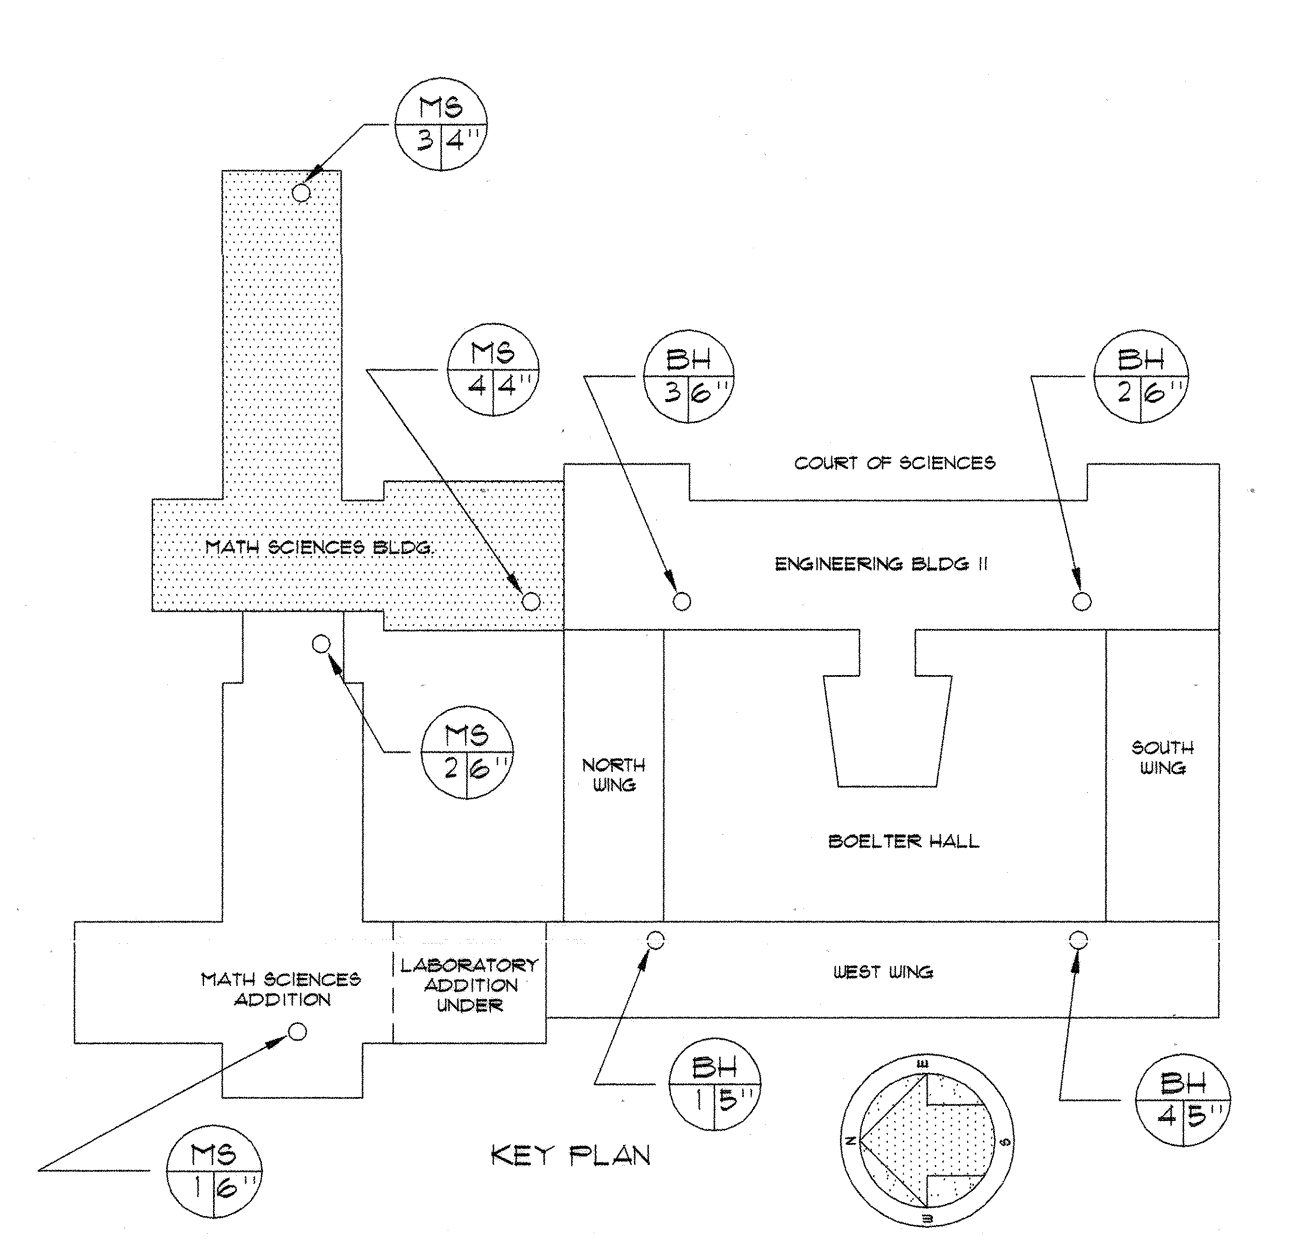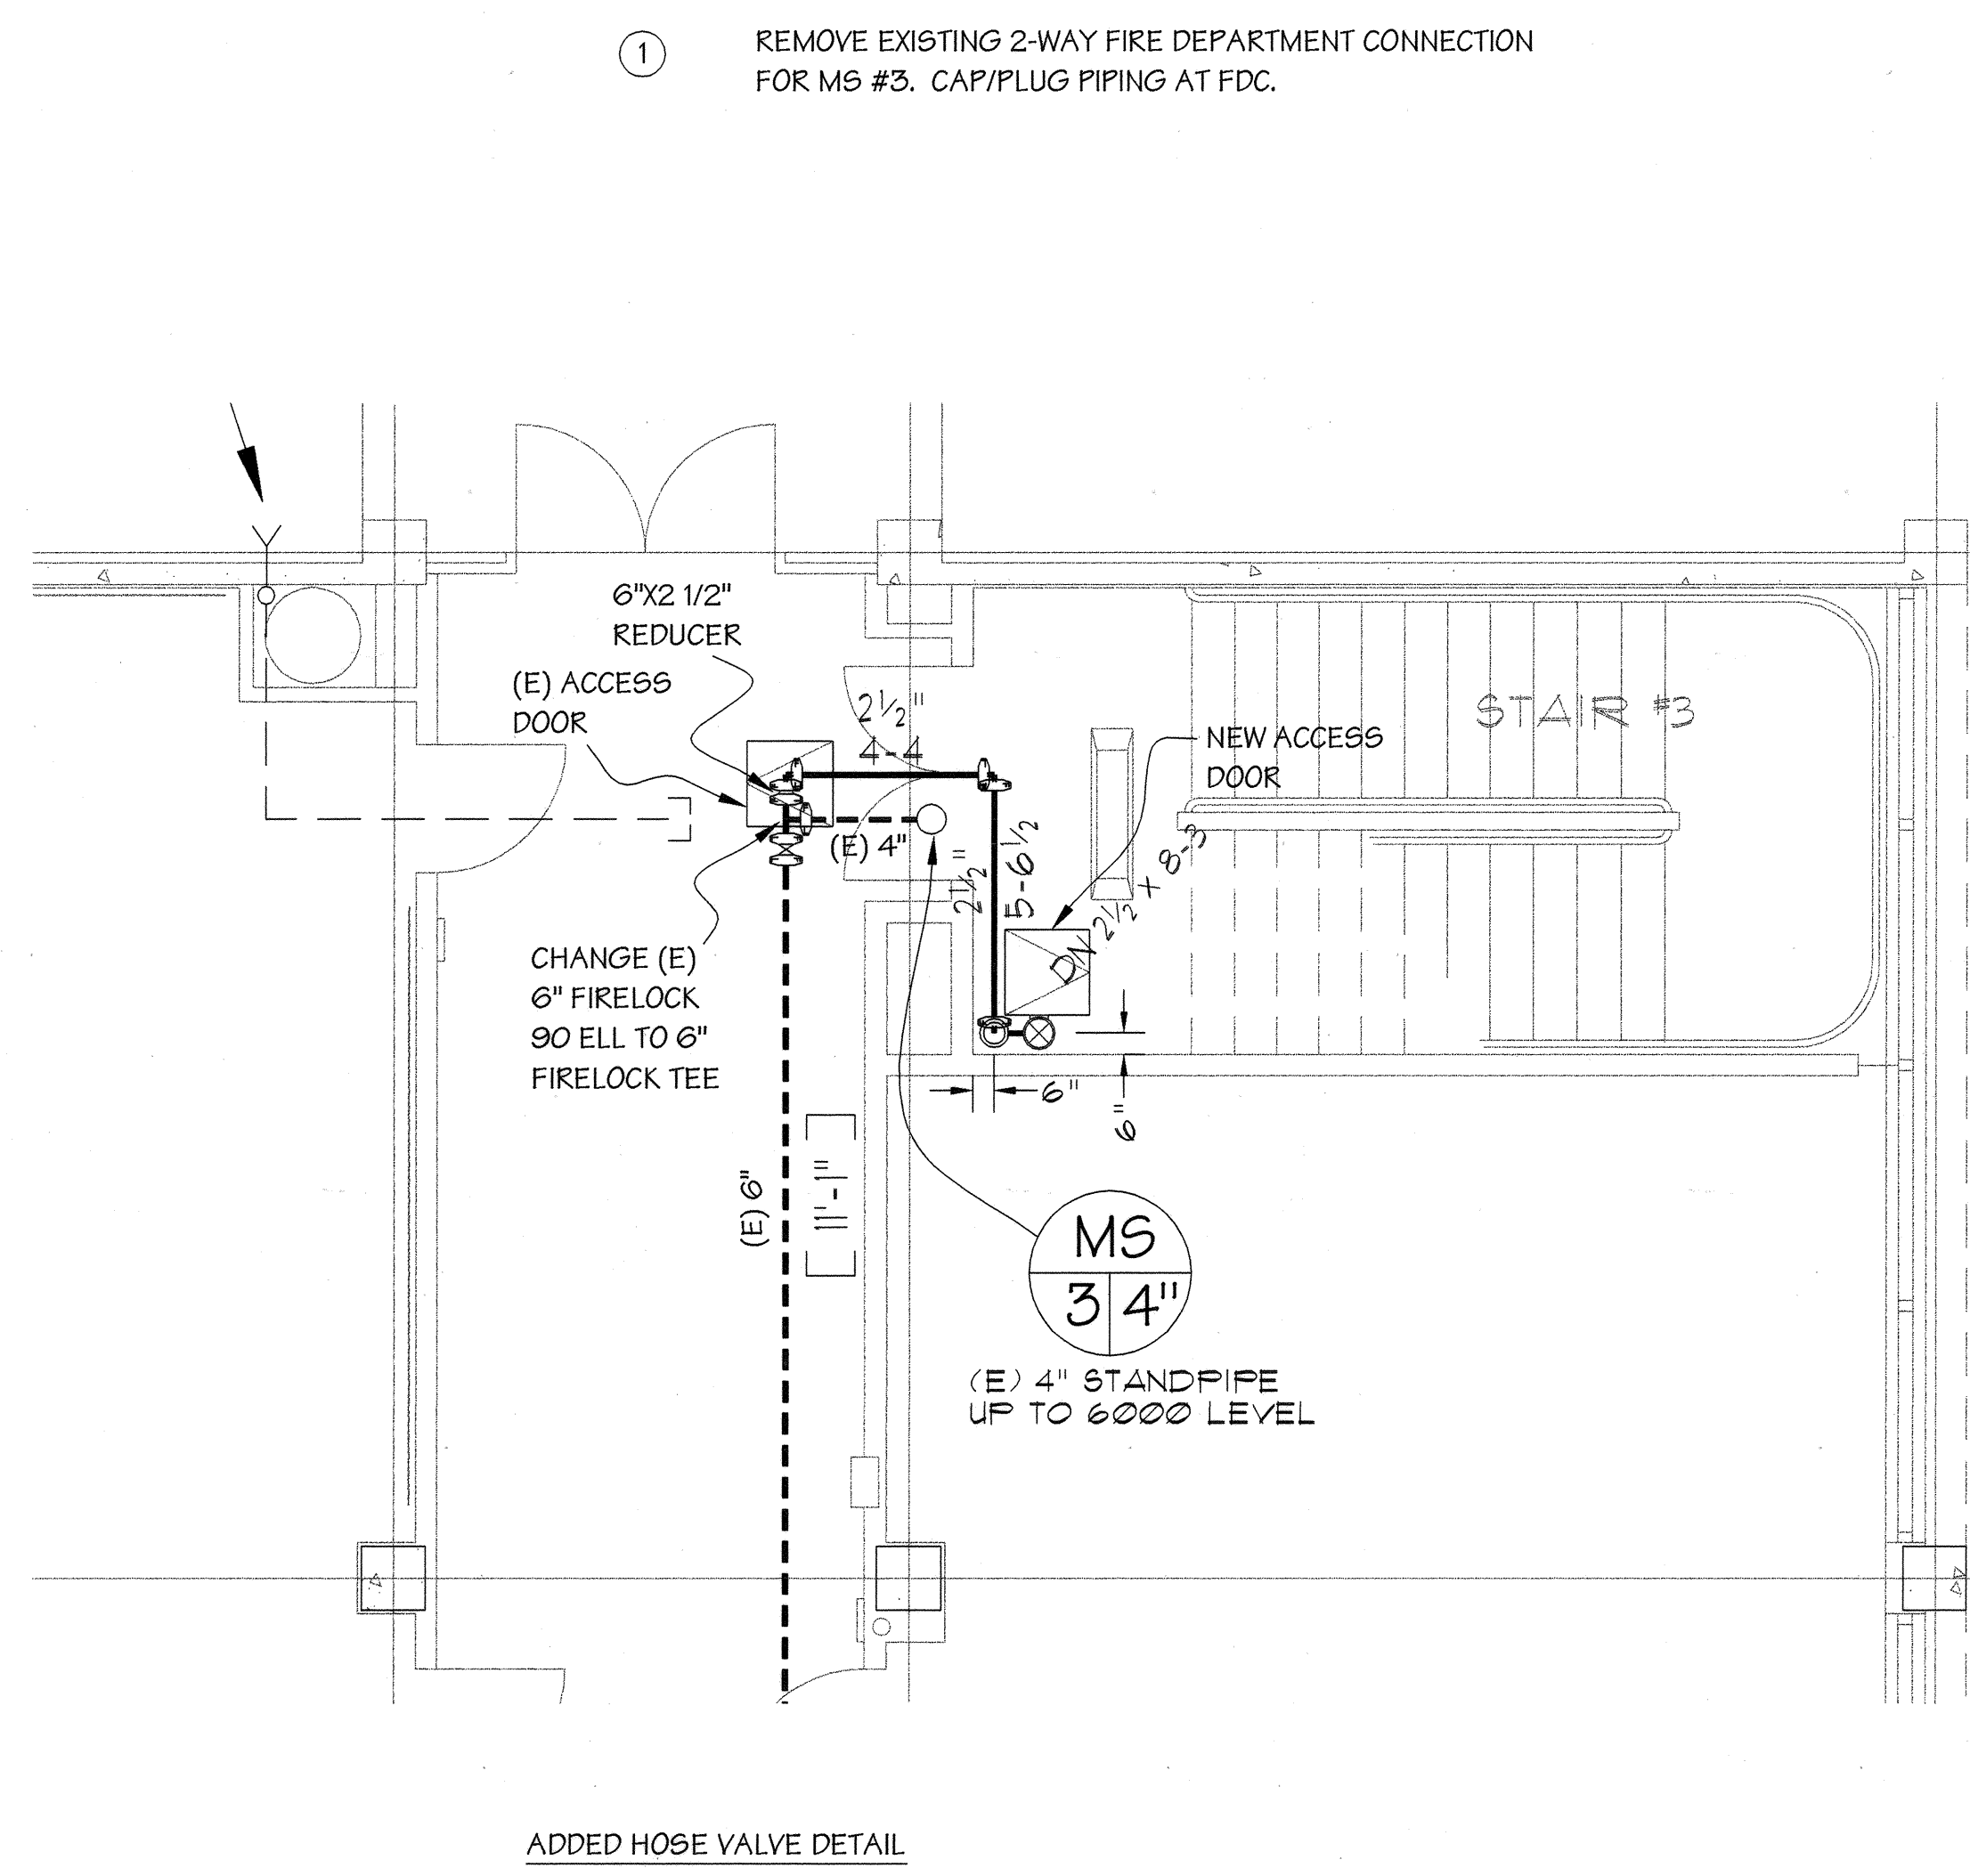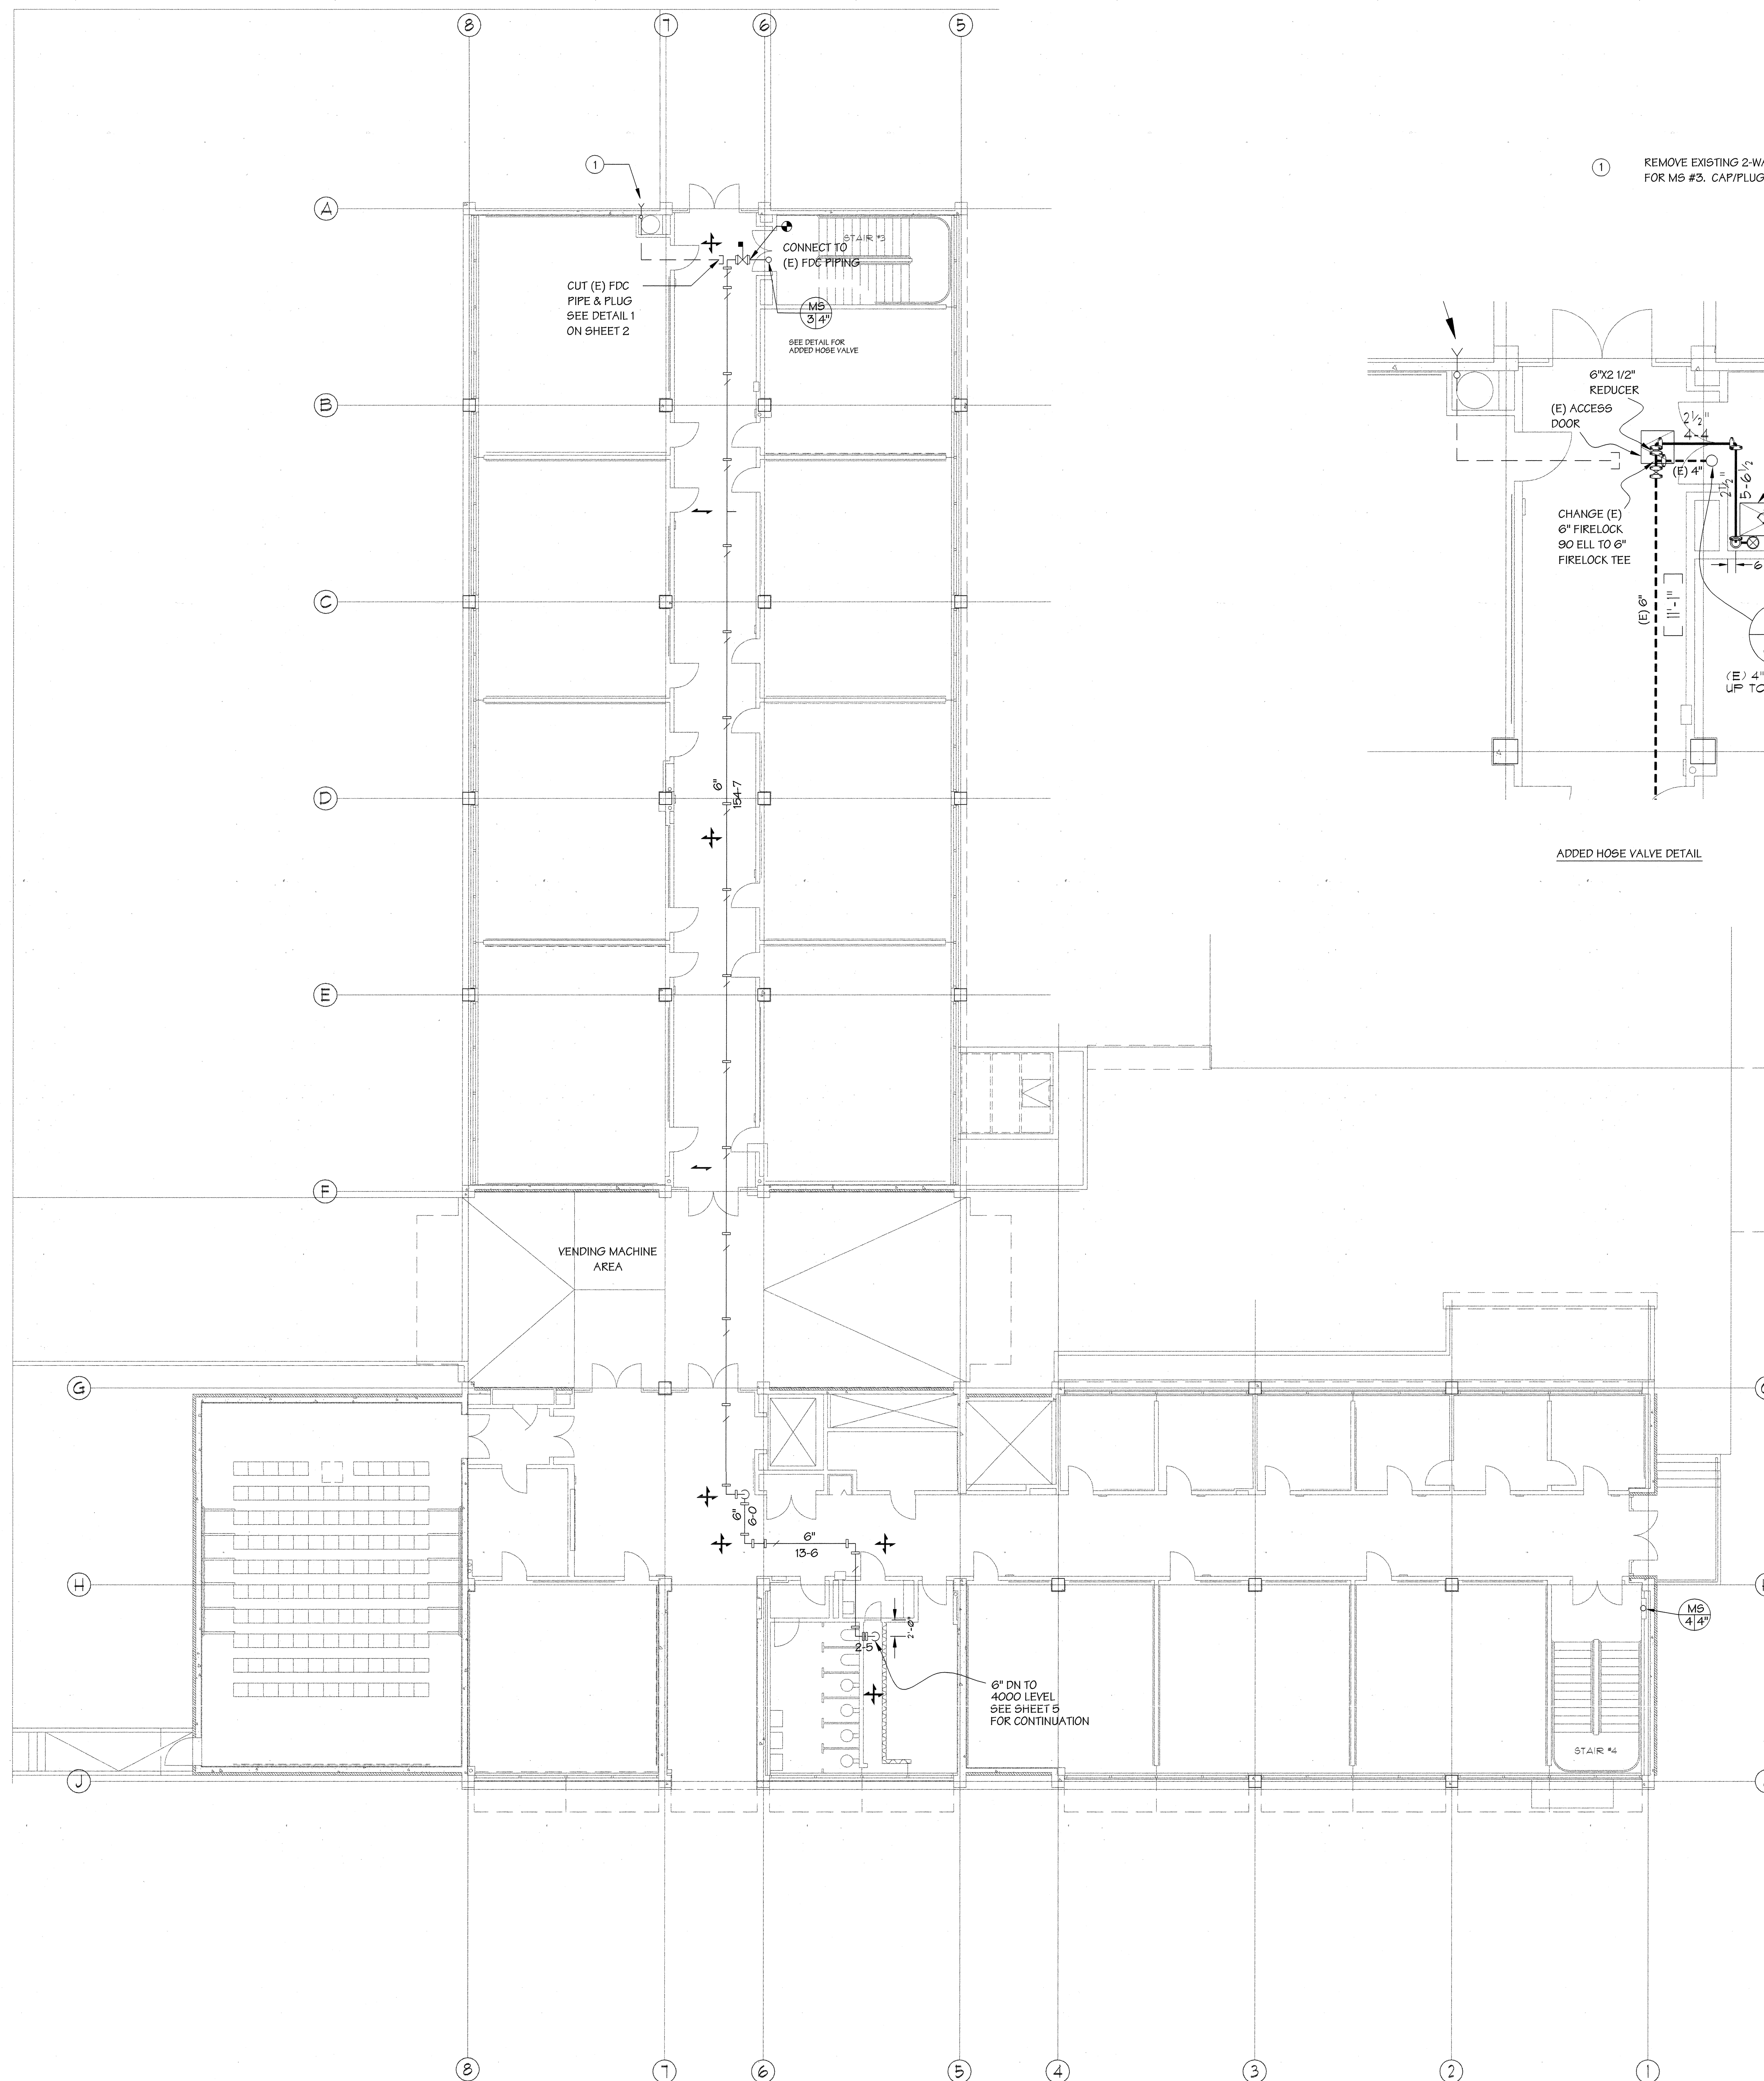


AS BUILT
UCLA PROJECT NO. 946237.01




AUTOMATIC FIRE PROTECTION PLAN			
UCLA BOELTER HALL FIRE SPRINKLER SYSTEM 5000 LEVEL WET STANDPIPE MATH SCIENCES			
OWNER	UCLA	BLDG. MS	DATE 10/2/04
CONTRACTOR	DIRECT	START 5000	DRAWN BY RFB
JOB NO.	04-11	SCALE 1/8" = 1'-0"	APPROVED BY
LINK-NILSEN CORPORATION		SHEET NO. 6 OF 26	
<small>LINK-NILSEN CORPORATION 150 SOUTH GATE AVENUE GARDEN GATE, CALIF. 90130 TEL: 626-252-2200 FAX: 626-252-3414</small>			

NOTE: COMPLETE SPRINKLER SYSTEM DRAWINGS TO BE SUBMITTED IN THE FUTURE. THIS DRAWING IS PROVIDED TO SHOW THE MOST HYDRAULICALLY DEMANDING REMOTE AREA TO VERIFY ADEQUATE WATER SUPPLY AND PIPE SIZING FOR EACH LEVEL OF SPRINKLER SYSTEM.

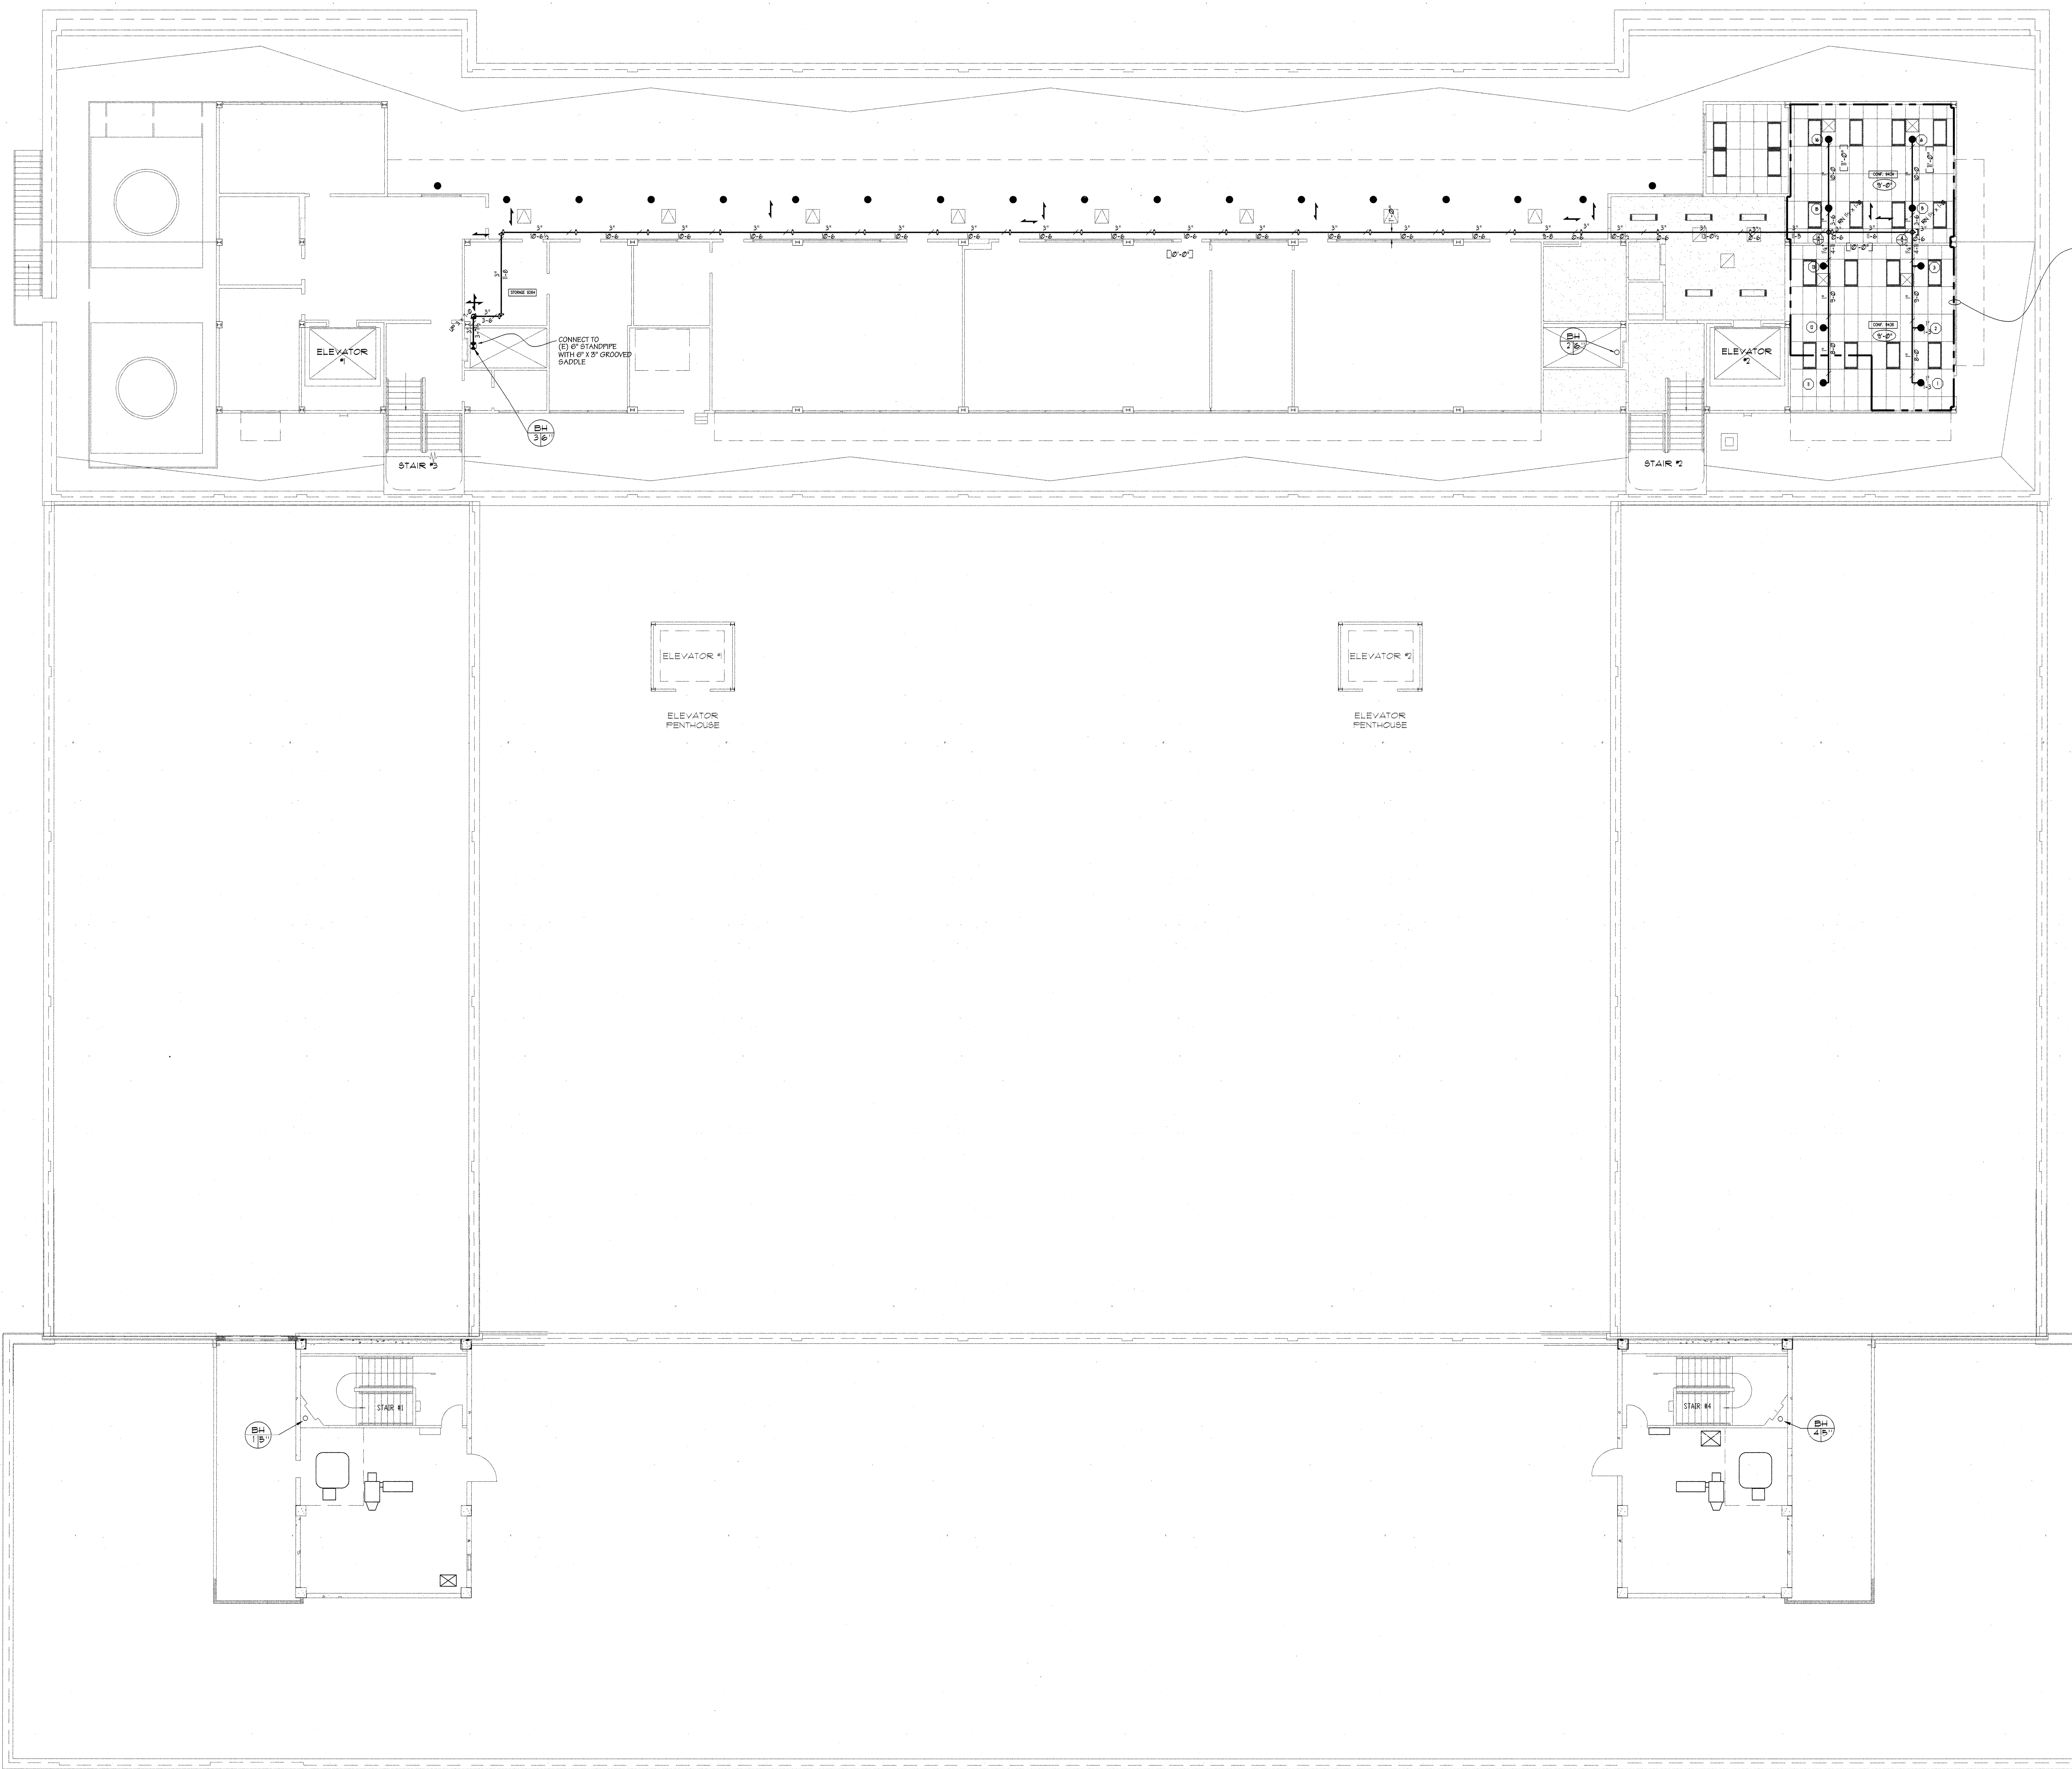

REMOTE AREA #1
 854 SQ. FT.
 OCCUPANCY HAZARD GROUP 2
 30 GPM @ 150 PSI
 8 FEET FLOWING
 K-1.6

NOTE: REDUCION IN DESIGN WPA
 PER NFPA 13 (9) 7-2.3.2.4

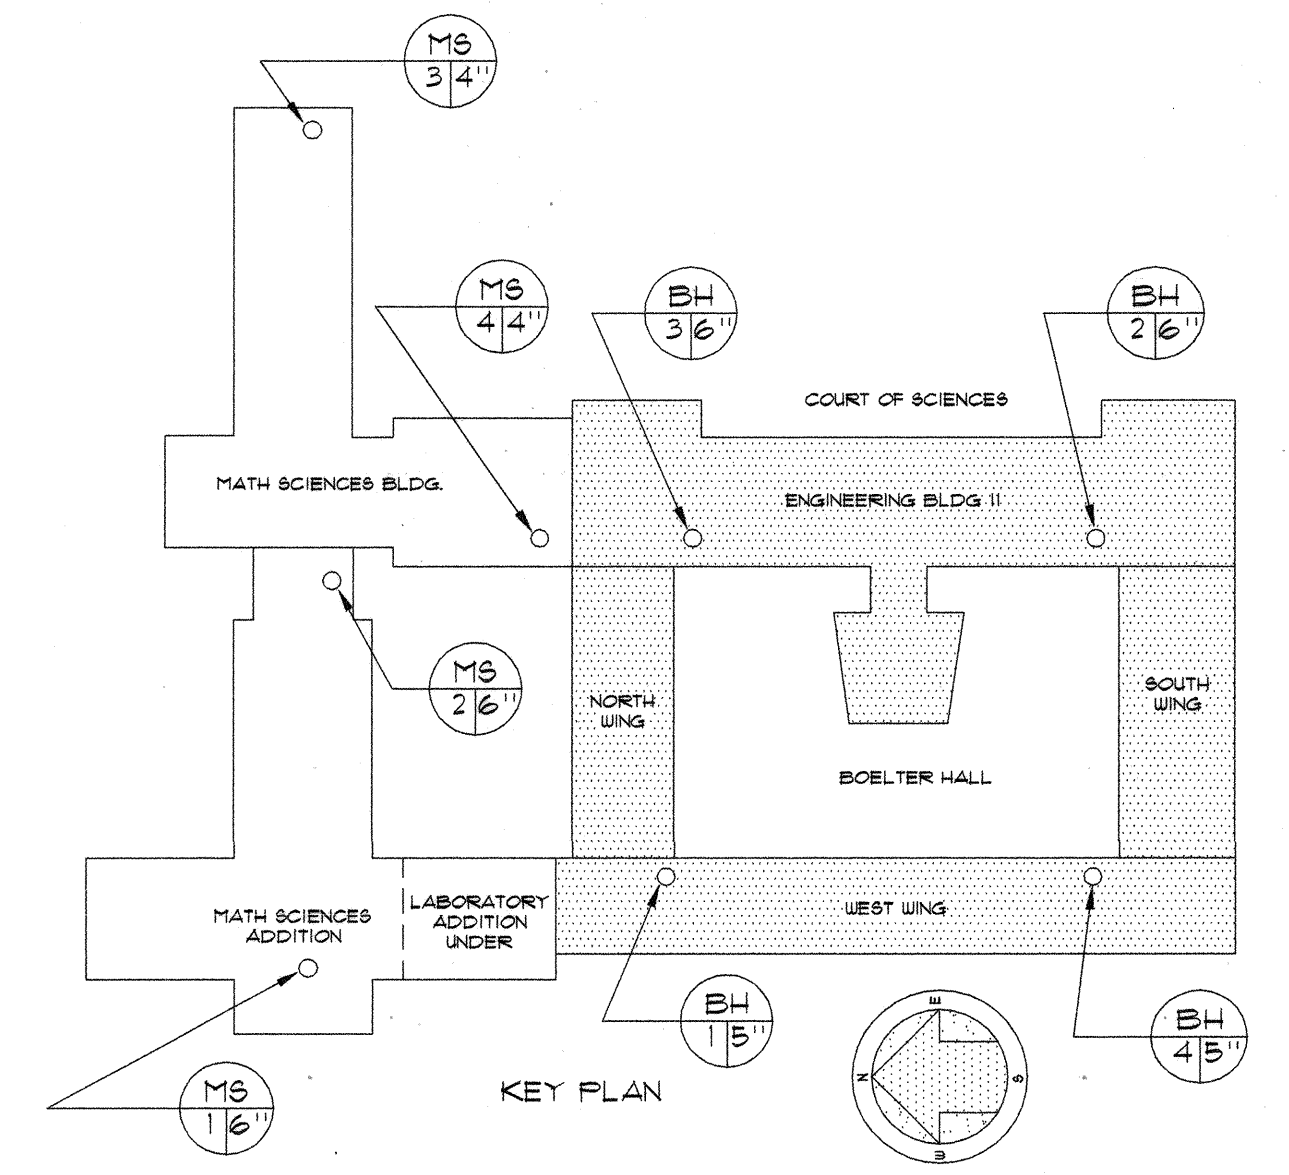

NOTE: THIS SHEET IS FOR RECORD ONLY. FOR AS-BUILT INSTALLATION AT THIS LEVEL SEE SHEET 18.



AS BUILT
 UCLA PROJECT NO. 946237.01

AUTOMATIC FIRE PROTECTION PLAN

UCLA - BOELTER HALL FIRE SPRINKLER SYSTEM
 9000 LEVEL WET STANDPIPE & PARTIAL SPRINKLER

OWNER	UCLA	BLDG.	SH	DATE	10/27/04
CONTRACTOR	DIRECT	SCALE	1/8" = 1'-0"	APPROVED BY	LINK-NILSEN CORPORATION
JOB NO.	04-11	SHEET NO.	7 OF 26	DATE	10/27/04



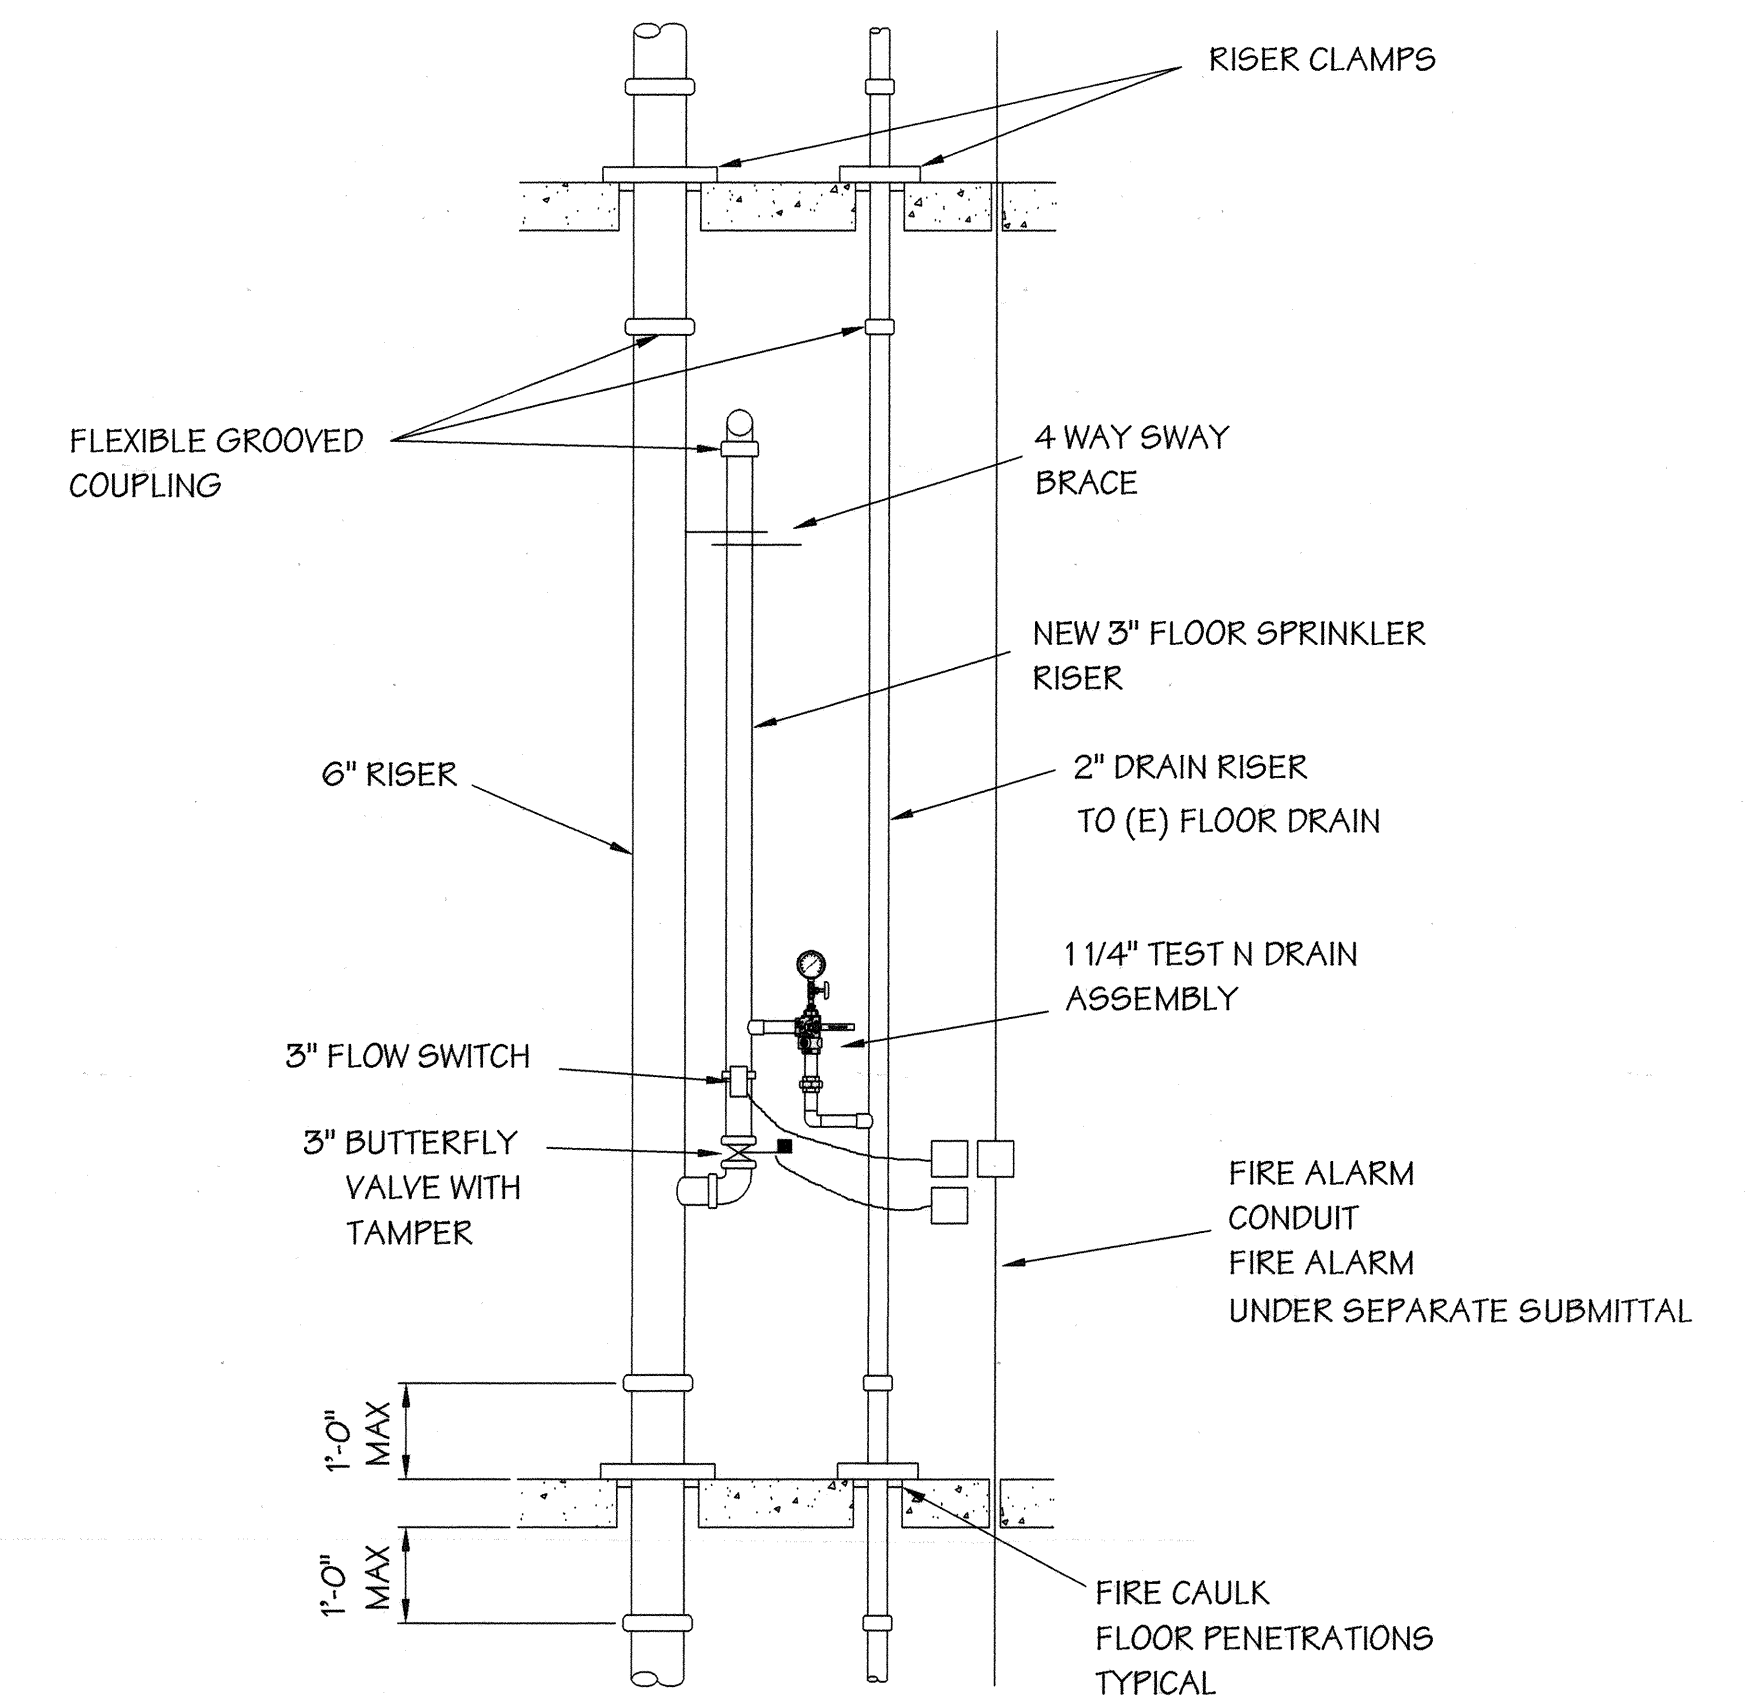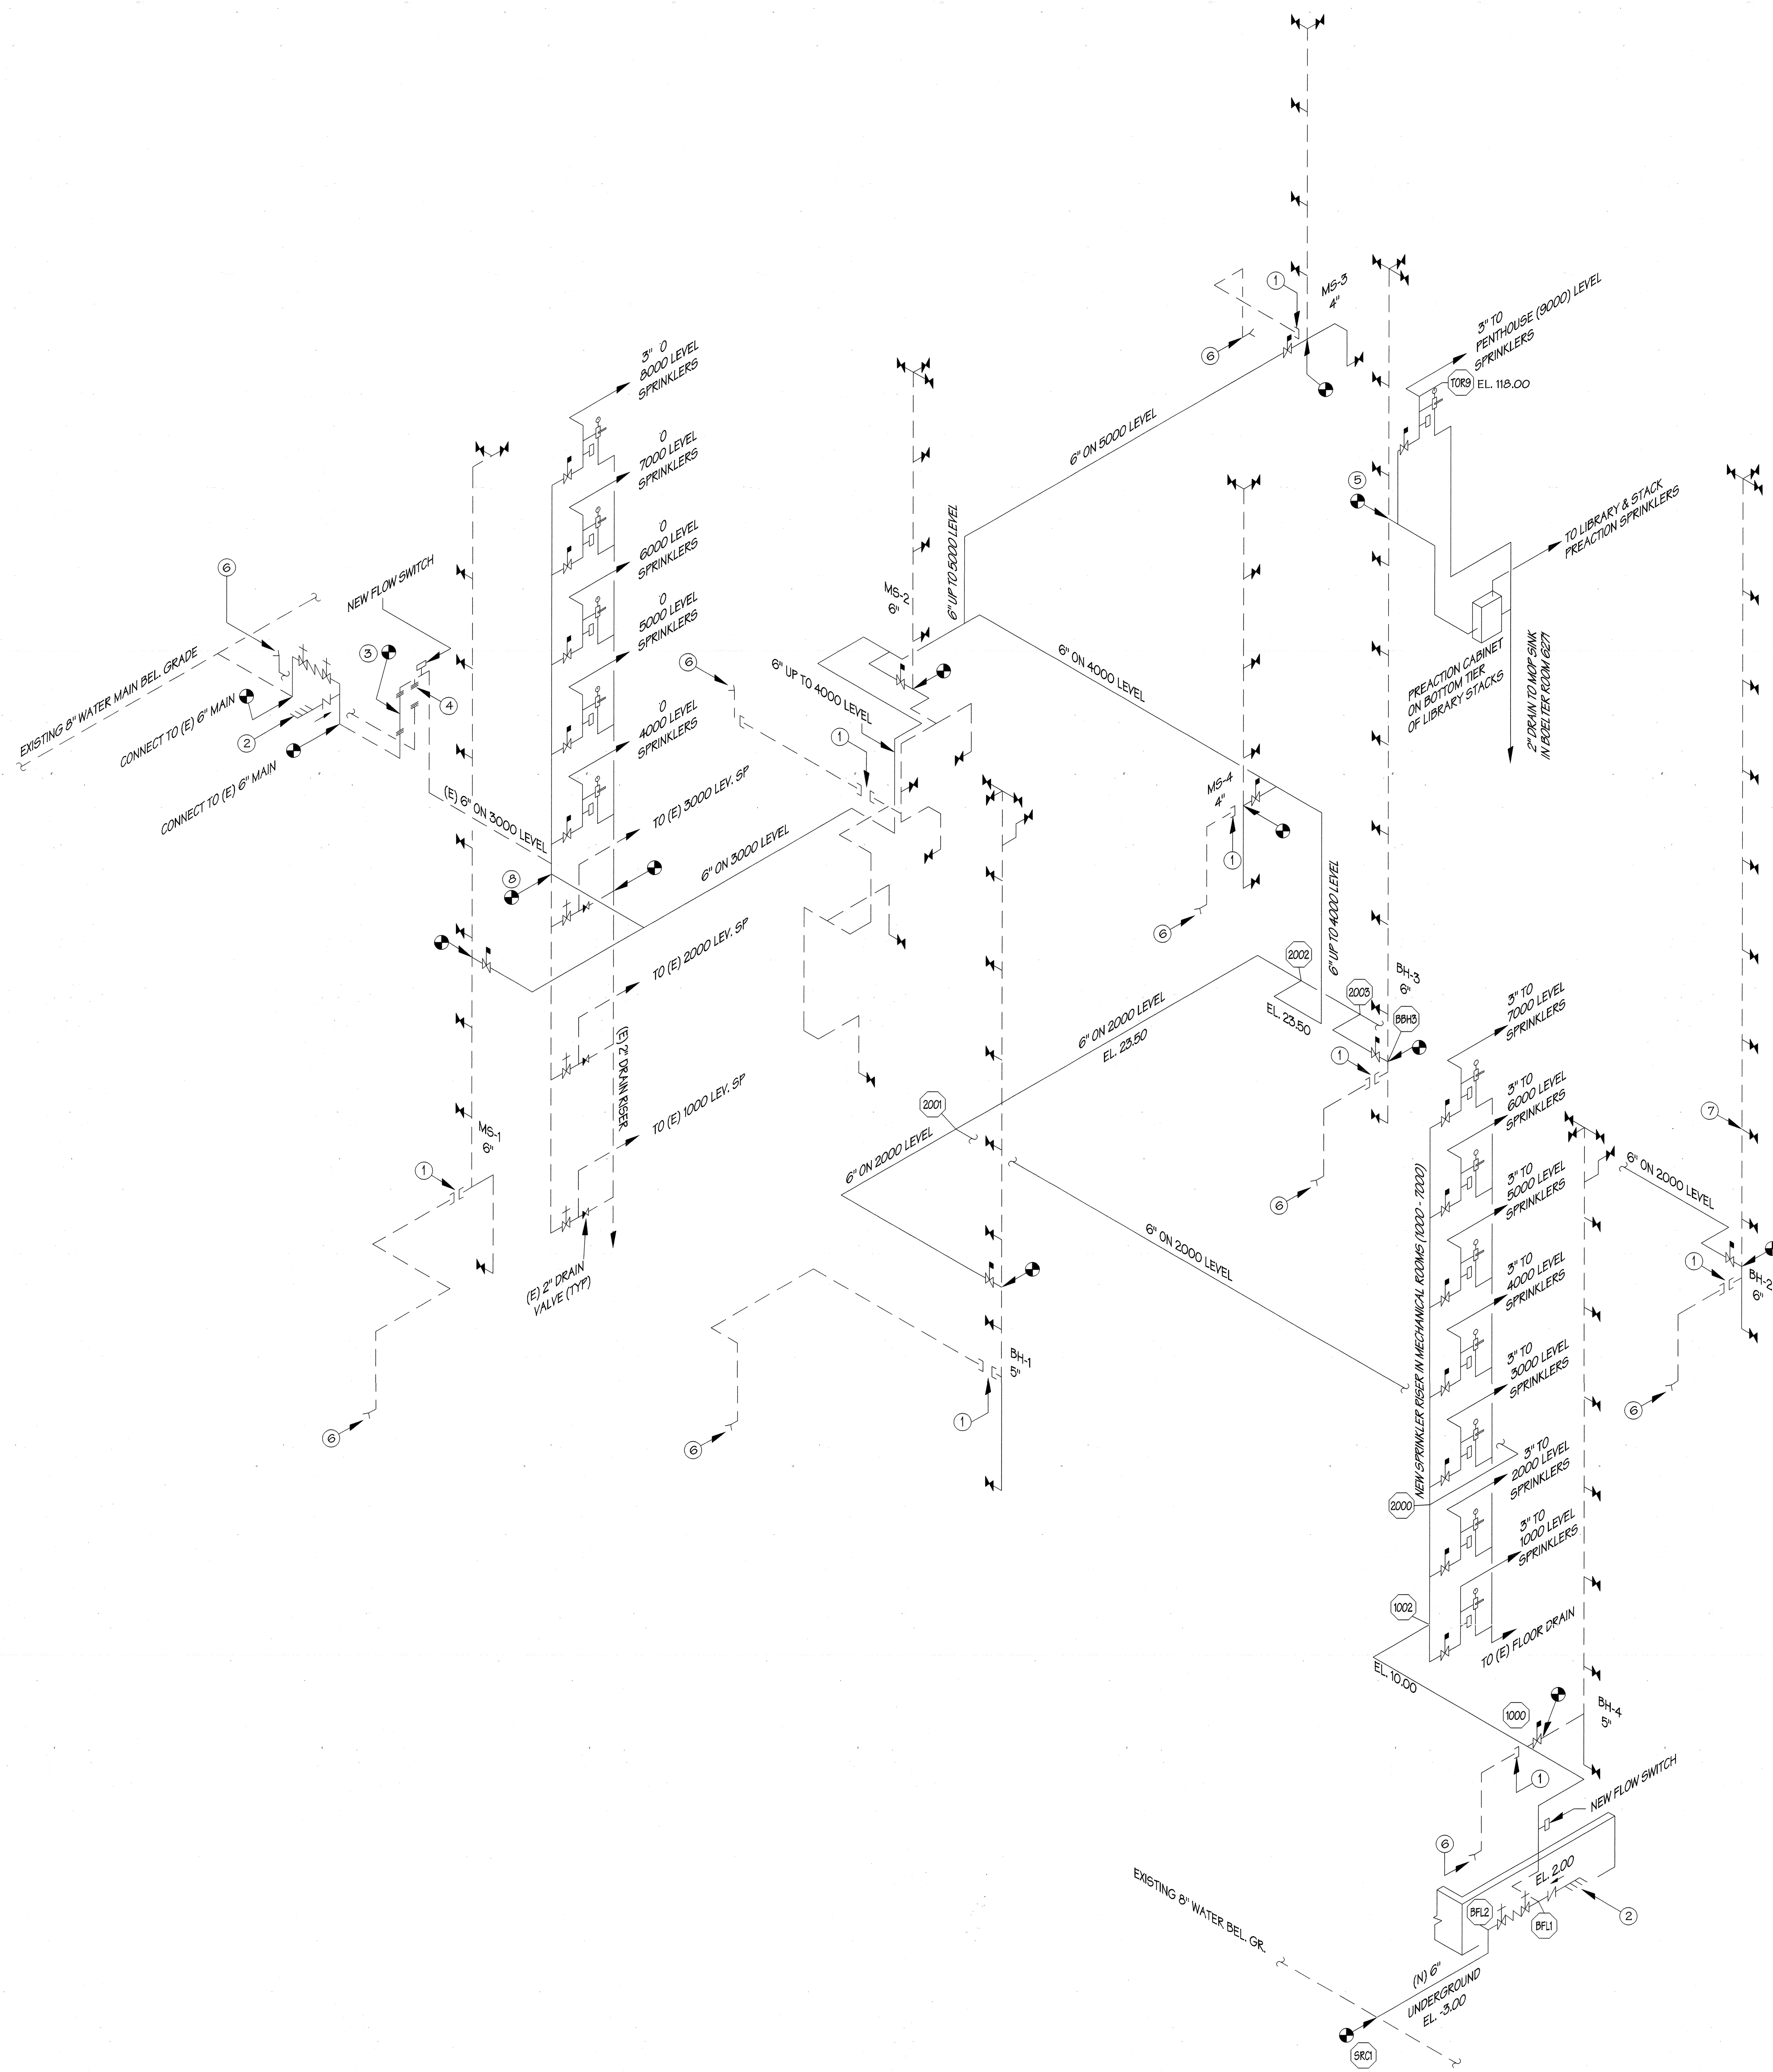

SPRINKLER RISER ASSEMBLY DETAIL (TYPICAL)

CONSTRUCTION NOTES:

- 1 CAP AND OR PLUG EXISTING CONNECTION TO RISER
- 2 NEW 6" DOUBLE CHECK BACKFLOW PREVENTER AND 4-WAY X 6" FIRE DEPARTMENT CONNECTION
- 3 REMOVE EXISTING OS&Y VALVE AND ALARM VALVE AND INSTALL NEW FLANGED SPOOL
- 4 REMOVE EXISTING CHECK VALVE AND INSTALL BLIND FLANGES
- 5 CONNECT TO EXISTING RISER FOR SUPPLY TO 9000 LEVEL SPRINKLERS AND LIBRARY PREACTION SYSTEM
- 6 REMOVE EXISTING FIRE DEPARTMENT CONNECTION & ANY EXPOSED PIPING PATCH HOLES IN WALLS OR FLOORS WITH LIKE MATERIAL
- 7 REMOVE EXISTING HOSE GATE VALVE AND REPLACE WITH NEW WET TYPE HOSE VALVES
- 8 CONNECT TO EXISTING 6" FIRE SPRINKLER RISER IN MECH. ROOM 3940 AND EXTEND AS SHOWN

LEGEND:

- EXISTING PIPE
- NEW PIPE
- NEW WET TYPE 2 1/2" HOSE VALVE
- NEW OS&Y VALVE W/ TAMPER SWITCH
- NEW BUTTERFLY VALVE W/ TAMPER SWITCH
- NEW TEST N DRAIN ASSEMBLY W/ GAUGE
- NEW WATERFLOW SWITCH
- EXISTING SYSTEM DRAIN VALVE








AS BUILT
UCLA PROJECT NO. 246237.01



AUTOMATIC FIRE PROTECTION PLAN
UCLA - BOELTER HALL FIRE SPRINKLER SYSTEM
ISOMETRIC SCHEMATIC DIAGRAM

OWNER	UCLA	BLDG. #815	DATE 10/2/04
CONTRACTOR	DIRECT	SCALE NONE	APPROVED BY

LINK-NILSEN CORPORATION
13700 SANTA MONICA ST., SUITE 3100, SANTA MONICA, CA 90405
PHONE (805) 445-3414 FAX (805) 445-3752

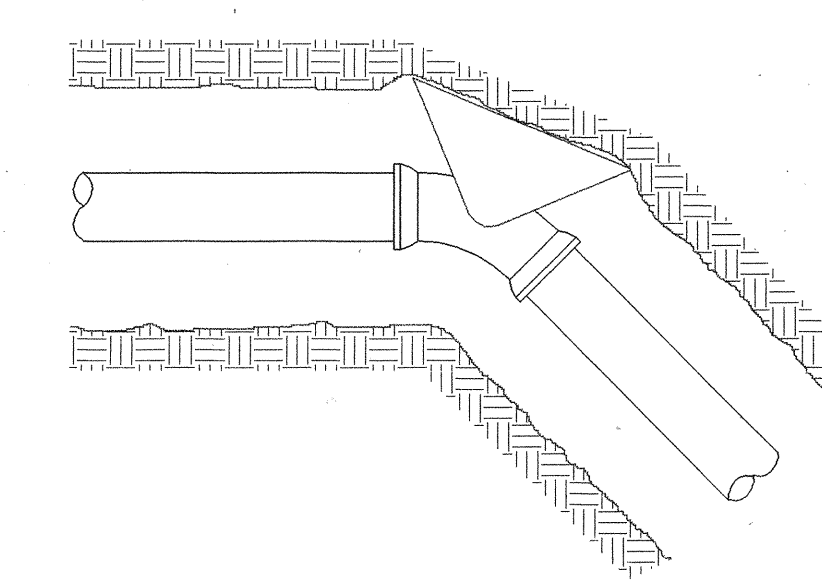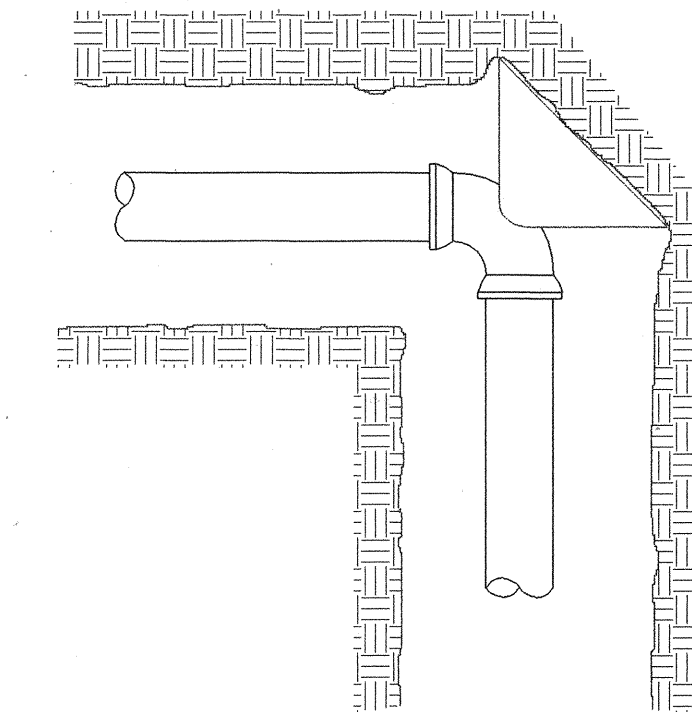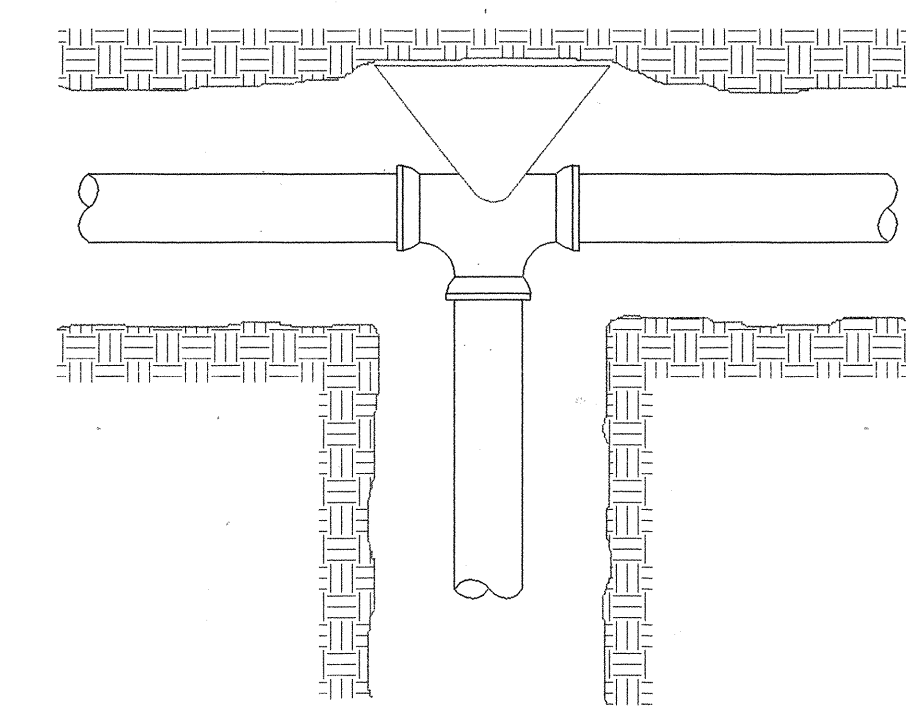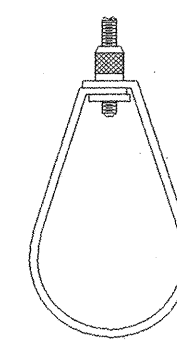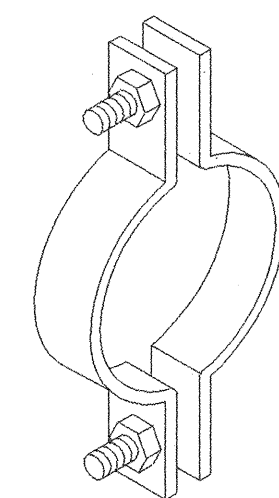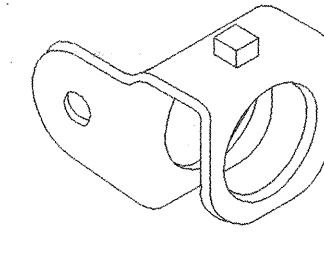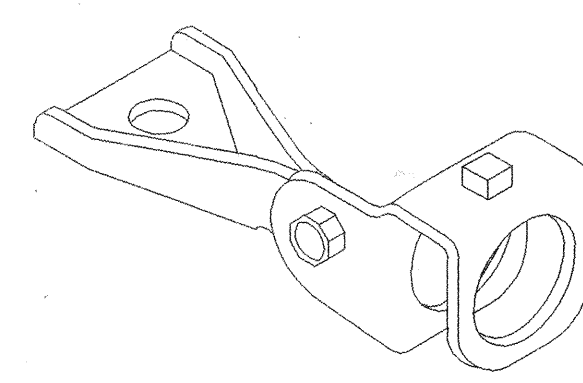

SWIVEL SWAY BRACE FITTING - AFCON #077
 Size Range - 1 & 1/4 inch bracing pipe.
 Material - Carbon Steel
 Approvals - Underwriters' Laboratories listed.
 Finish - Plain

SWIVEL SWAY BRACE FITTING - AFCON #078
 Size Range - 1 & 1/4 inch bracing pipe.
 Material - Carbon Steel
 Approvals - Underwriters' Laboratories listed.
 Finish - Plain

PIPE CLAMP FOR SWAY BRACING - AFCON #410
 Size Range - 4 inch thru 8 inch
 Material - Carbon Steel
 Approvals - Underwriters' Laboratories listed.
 Finish - Plain

ADJUSTABLE RING HANGER

Size Range - 1" thru 6" inch pipe.
 Material - Steel, Mil. Galvanized to G-90 speci-
 Approvals - Underwriters' Laboratories Listed and
 Factory Mutual Engineering approved. Conforms
 to Federal Specifications WW-H-171E, type 10, and
 Manufacturers Standardization Society SP-69,
 type 10.



CONDITION A
DEAD END

CONDITION B
90° BEND

CONDITION C
45° BEND OR LESS

PIPE SIZE	THRUST BLOCK BEARING AREA		
	A	B	C
4"	2	2	2
6"	4	5	3
8"	6	8	5
10"	9	13	7


- VALUES SHOWN ARE BASED ON A WATER PRESSURE OF 225 PSI.
- VALUES SHOWN ARE BASED ON SOIL TYPE WITH 2000 PSF. THE VALUES IN THE TABLE ABOVE SHOULD BE MULTIPLIED BY THE FOLLOWING FACTORS FOR OTHER SOIL CONDITIONS:
 SOFT CLAY = 4
 SAND = 2
 SAND AND GRAVEL = 1.33
 SHALE = .4

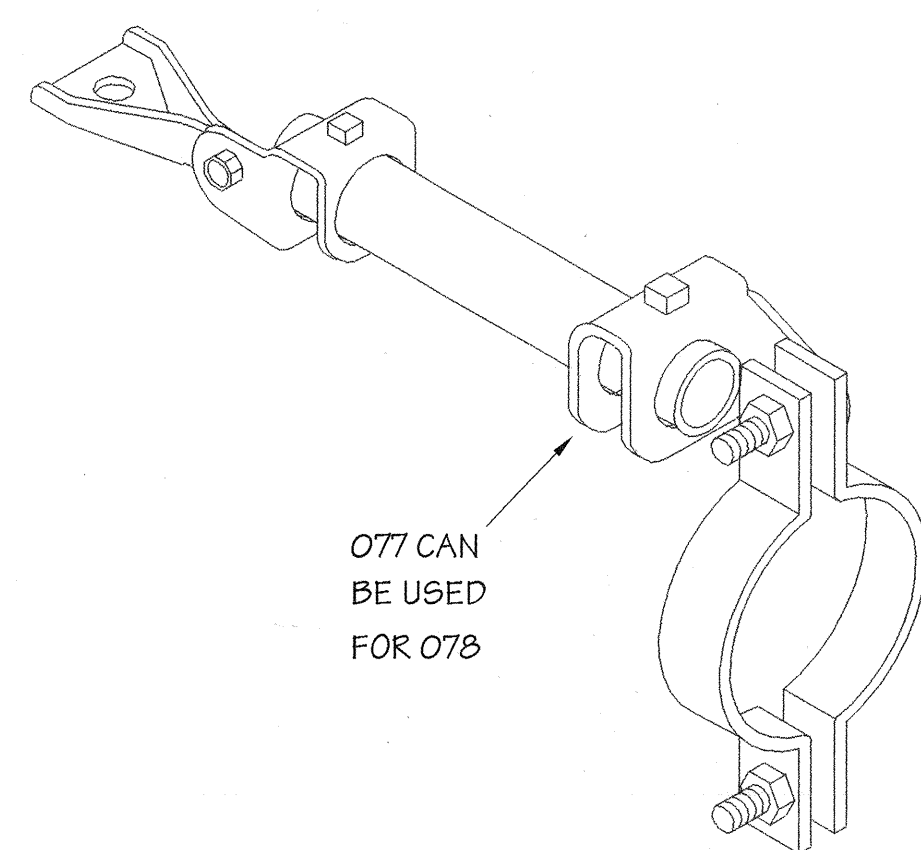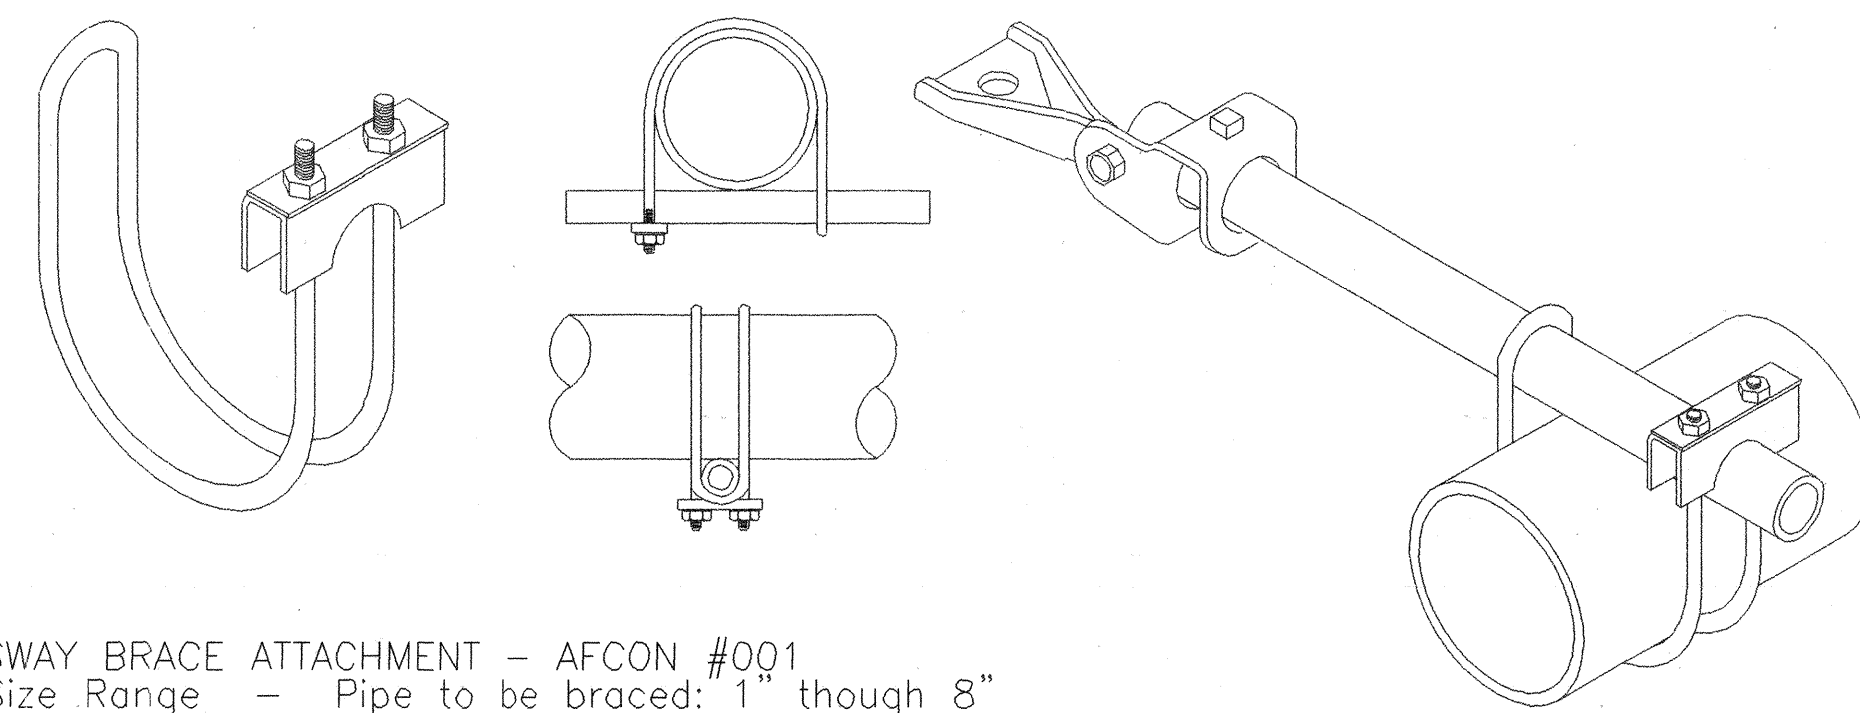

SWAY BRACE ATTACHMENT - AFCON #001
 Size Range - Pipe to be braced: 1" through 8"
 Material - 1" and 1 1/4" bracing pipe
 Approvals - Underwriters' Laboratories listed.
 Finish - Plain

TYPICAL LATERAL BRACE

TYPICAL LONGITUDINAL BRACE

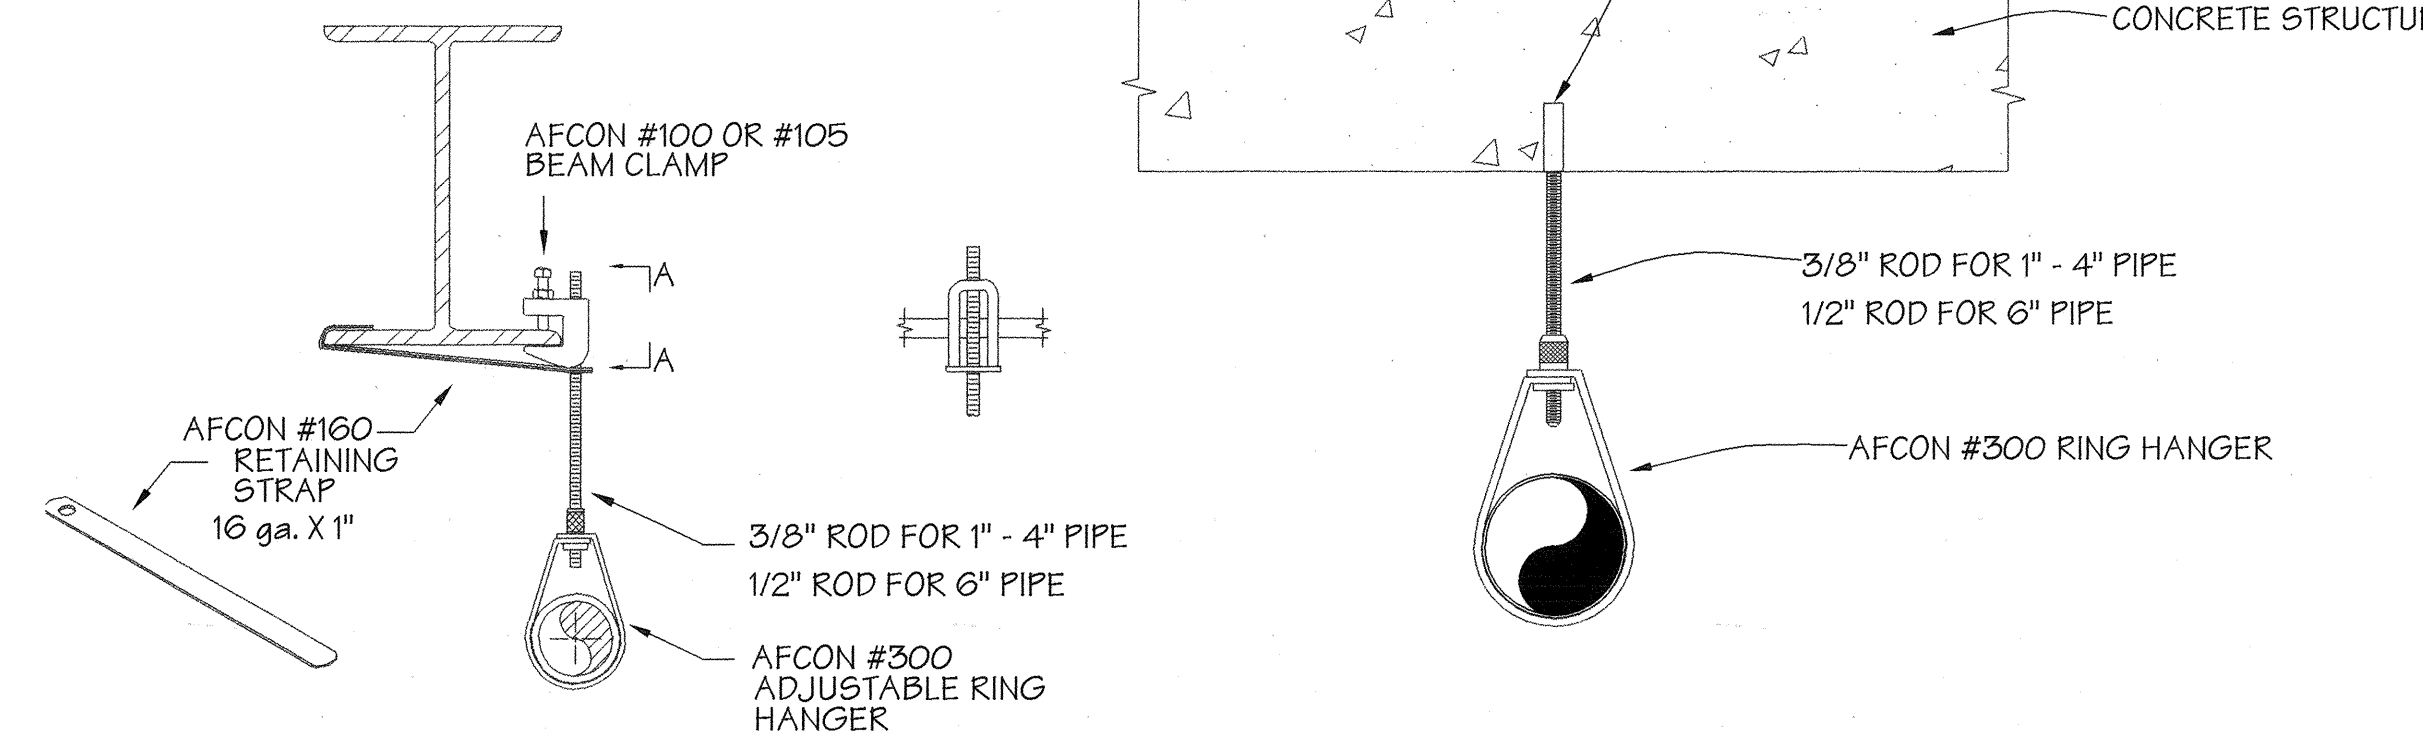

TYPICAL HANGER DETAILS




SCALE: N.T.S.

THRUST BLOCK DETAIL


SCALE: N.T.S.

UNDERGROUND NOTES:

- PROVIDE MINIMUM 30" DEPTH OF BURY.
- MATERIAL TO BE USED:
 UNDERGROUND PIPING - DUCTILE IRON PIPE, AWWA C151, AWWA C150, PRESSURE CLASS 350
 UNDERGROUND FITTINGS - MECHANICAL JOINT AND PLAIN END FITTINGS AWWA C110, CLASS 250, AND MECHANICAL JOINT RESTRAINTS
- ALL UNDERGROUND PIPING SHALL BE FLUSHED BEFORE CONNECTION IS MADE TO EXISTING FIRE SPRINKLER RISERS.
- ALL WORK TO BE DONE IN ACCORDANCE WITH NFPA13 1999 SECTION 5-14.4

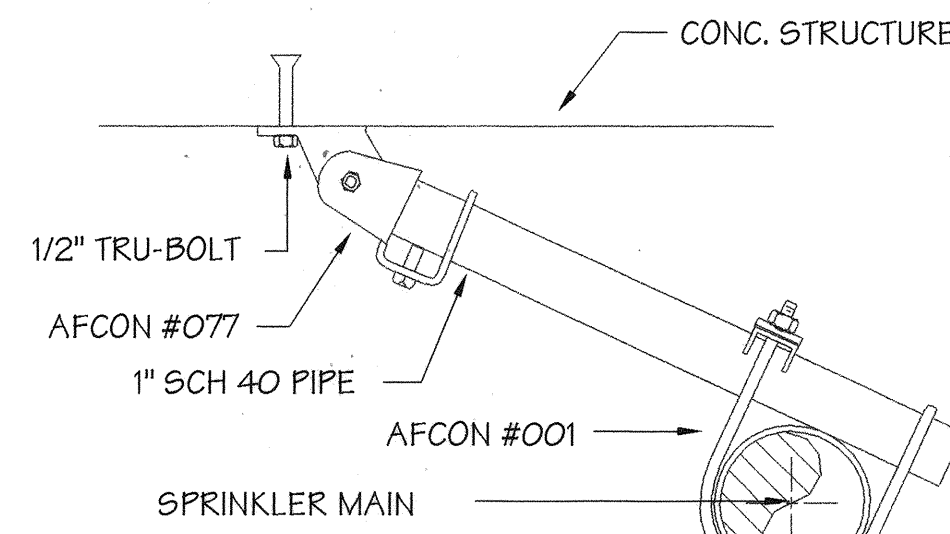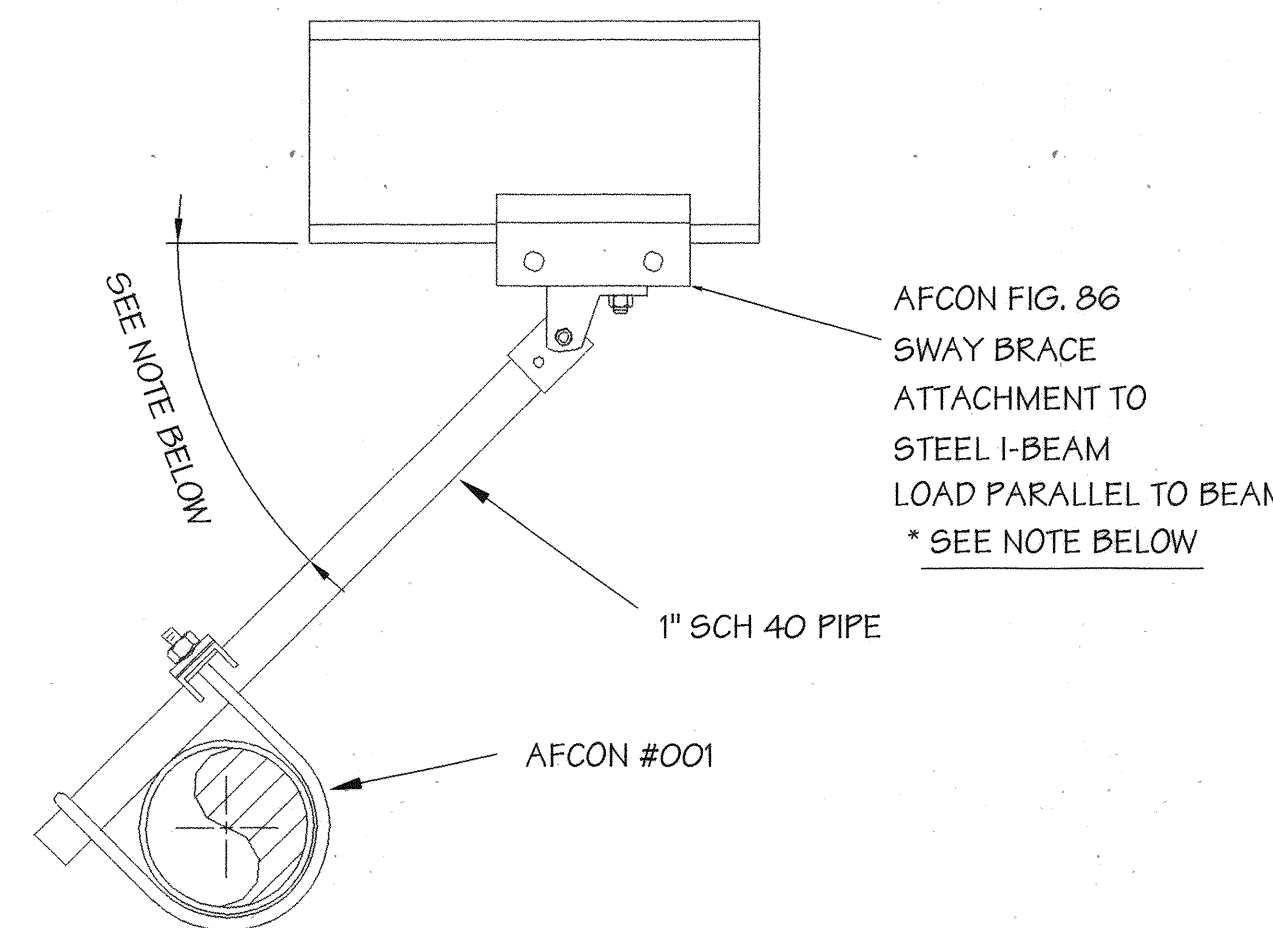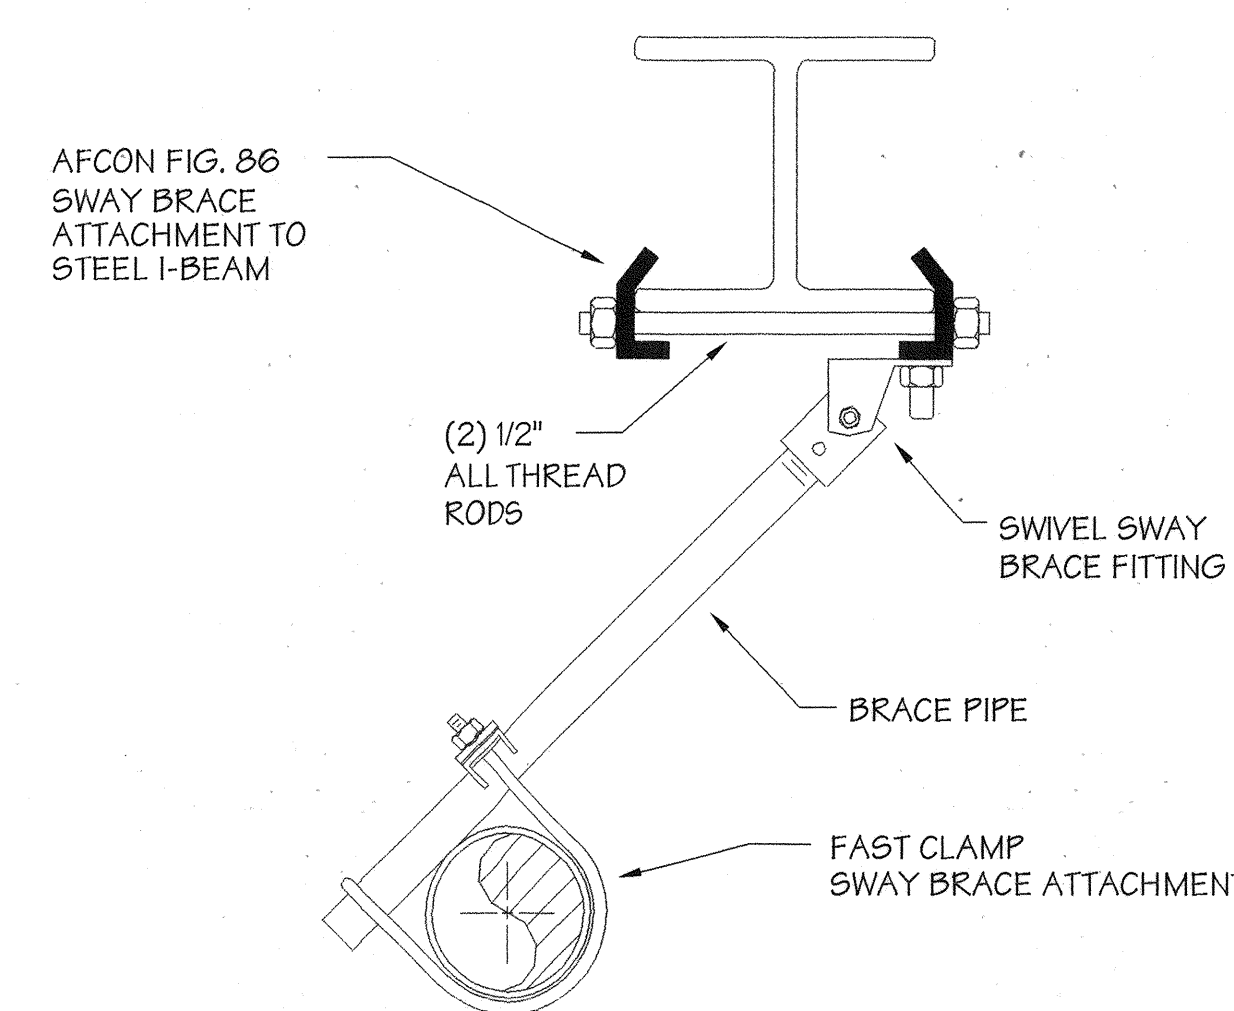

NOTE: PER CALCS BELOW, WHEN USING THE AFCON FIG. 86 TO ATTACH TO A STEEL BEAM, IF THE LOAD IS PARALLEL TO THE LENGTH OF THE BEAM, AS SHOWN ABOVE, THE MAXIMUM SPACING OF BRACES FOR 6" SCH 40 PIPE IS AS FOLLOWS:
 38'-11" IF BRACE ANGLE IS 30 DEG. TO 44 DEG. FROM VERTICAL (LATERAL OR LONGITUDINAL BRACE)
 56'-5" IF BRACE ANGLE IS 45 DEG. TO 59 DEG. FROM VERTICAL (LONGITUDINAL BRACE ONLY)
 69'-1" IF BRACE ANGLE IS 60 DEG. TO 89 DEG. FROM VERTICAL (LONGITUDINAL BRACE ONLY)

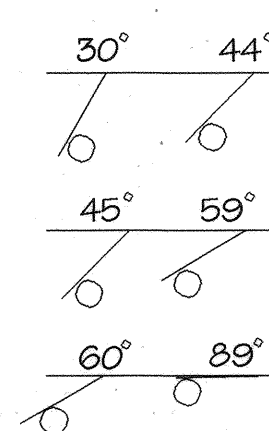

BRACING DETAILS

Seismic Bracing Calculations					
Project: UCLA - BOELTER HALL					
Address: 520 & 580 PORTOLA PLAZA					
Brace Information			Seismic Brace Attachments		
Length of brace	7'-0" MAX.	Structure attachment fitting or tension-only system:	Make: AFCON	Model: 077	
Diameter of brace	1"	Listed load rating	2025	Adjusted load rating	1425 per 6-4.5.10
Type of brace	SCH. 40	Sway brace (pipe attachment) fitting:	Make: AFCON	Model: 077 OR 078 & 410	
Angle of brace	45° TO 59°	Listed load rating	2025	Adjusted load rating	1425 per 6-4.5.10
Least radius of gyration *	0.42	LR value *	200	Maximum horizontal load	2500
Fastener Information			Seismic Brace Assembly Detail		
Orientation of connecting surface	B				
Fastener:	EXPANSION SHIELD	Brace Identification: <input type="checkbox"/> Lateral brace <input type="checkbox"/> Longitudinal brace			
Type	EXPANSION SHIELD				
Diameter	1/2"				
Length	3.1/4" EMBEDMENT				
Maximum load	1722				
Sprinkler System Load Calculation					
Diameter	Type	Length (ft)	Total (ft)	1/2 Weight per ft	1/2 Total Weight
6"	SCH. 40	80'	80'	15.85	1268
Total 1/2 weight of water-filled pipe: 1268					

Seismic Bracing Calculations					
Project: UCLA - BOELTER HALL					
Address: 520 & 580 PORTOLA PLAZA					
Brace Information			Seismic Brace Attachments		
Length of brace	10'-6"	Structure attachment fitting or tension-only system:	Make: AFCON	Model: 077	
Diameter of brace	1"	Listed load rating	2025	Adjusted load rating	1007.5 per 6-4.5.10
Type of brace	SCH. 40	Sway brace (pipe attachment) fitting:	Make: AFCON	Model: 001	
Angle of brace	30° TO 44°	Listed load rating	2025	Adjusted load rating	1007.5 per 6-4.5.10
Least radius of gyration *	.42	LR value *	300	Maximum horizontal load	726
Fastener Information			Seismic Brace Assembly Detail		
Orientation of connecting surface	A				
Fastener:	TRU-BOLT	Brace Identification: <input type="checkbox"/> Lateral brace <input type="checkbox"/> Longitudinal brace			
Type	TRU-BOLT				
Diameter	1/2"				
Embedment	3.1/4"				
Maximum load	922				
Sprinkler System Load Calculation					
Diameter	Type	Length (ft)	Total (ft)	1/2 Weight per ft	1/2 Total Weight
6"	SCH. 40	40'-0"	40'	15.85	634
Total 1/2 weight of water-filled pipe: 634					

Seismic Bracing Calculations					
Project: UCLA - BOELTER HALL					
Address: 520 & 580 PORTOLA PLAZA					
Brace Information			Seismic Brace Attachments		
Length of brace	7'-0" MAX.	Structure attachment fitting or tension-only system:	Make: AFCON	Model: AFCON 026	
Diameter of brace	1"	Listed load rating	2025	Adjusted load rating	1425 per 6-4.5.10
Type of brace	SCH. 40	Sway brace (pipe attachment) fitting:	Make: AFCON	Model: 077 OR 078 & 410	
Angle of brace	45° TO 59°	Listed load rating	2025	Adjusted load rating	1425 per 6-4.5.10
Least radius of gyration *	0.42	LR value *	300	Maximum horizontal load	2500
Fastener Information			Seismic Brace Assembly Detail		
Orientation of connecting surface	B				
Fastener:	STEEL BOLT	Brace Identification: <input type="checkbox"/> Lateral brace <input type="checkbox"/> Longitudinal brace			
Type	STEEL BOLT				
Diameter	1/2"				
Length	N/A				
Maximum load	2025				
Sprinkler System Load Calculation					
Diameter	Type	Length (ft)	Total (ft)	1/2 Weight per ft	1/2 Total Weight
6"	SCH. 40	80'	80'	15.85	1268
Total 1/2 weight of water-filled pipe: 1268					

Seismic Bracing Calculations					
Project: UCLA - BOELTER HALL					
Address: 520 & 580 PORTOLA PLAZA					
Brace Information			Seismic Brace Attachments		
Length of brace	10'-6"	Structure attachment fitting or tension-only system:	Make: AFCON	Model: 077 & 026	
Diameter of brace	1"	Listed load rating	1265	Adjusted load rating	632.5 per 6-4.5.10
Type of brace	SCH. 40	Sway brace (pipe attachment) fitting:	Make: AFCON	Model: 001	
Angle of brace	30° TO 44°	Listed load rating	2025	Adjusted load rating	1007.5 per 6-4.5.10
Least radius of gyration *	.42	LR value *	300	Maximum horizontal load	726
Fastener Information			Seismic Brace Assembly Detail		
Orientation of connecting surface	A				
Fastener:	STEEL BOLT	Brace Identification: <input type="checkbox"/> Lateral brace <input type="checkbox"/> Longitudinal brace			
Type	STEEL BOLT				
Diameter	1/2"				
Embedment	N/A				
Maximum load	1600				
Sprinkler System Load Calculation					
Diameter	Type	Length (ft)	Total (ft)	1/2 Weight per ft	1/2 Total Weight
6"	SCH. 40	39'-11"	39'-11"	15.85	633
Total 1/2 weight of water-filled pipe: 633					

SWAY BRACING CALCULATIONS FOR 6" MAIN

AS BUILT

UCLA PROJECT NO. 946237.01



AUTOMATIC FIRE PROTECTION PLAN					
UCLA - BOELTER HALL FIRE SPRINKLER SYSTEM HANGERS, BRACING & SUPPORT DETAILS & CALCS					
OWNER	UCLA	BLDG. #HMS	DATE	10/2/04	
CONTRACTOR	DIRECT	STORY	DRAWN BY	BJD	
APPROVED BY		SCALE	AS SHOWN		
JOB NO.	04-11	LINK-NILFEN CORPORATION	PROJ. NO.	946237.01	SHEET NO.
10000 1/4" = 1'-0"		10000 1/4" = 1'-0"		9 OF 26	